Contract Plans SILVER VILLAGE PAVEMENT PRESERVATION AND PEDESTRIAN IMPROVEMENTS

TULALIP INDIAN RESERVATION

SNOHOMISH COUNTY PROJECT NO. 2016-227


DESIGN STANDARDS:

ROAD CLASSIFICATION: RURAL MINOR ACCESS

STANDARD SPECIFICATIONS:

WSDOT STANDARD DETAILS

WSDOT STANDARD SPECIFICATIONS FOR ROAD, BRIDGE, AND MUNICIPAL CONSTRUCTION 2016

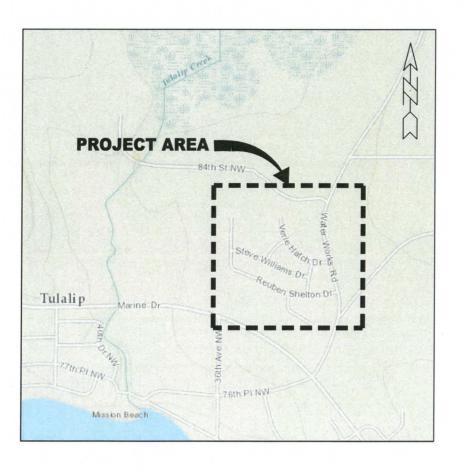

UTILITIES:

FRONTIER COMMUNICATIONS 1800 41st STREET EVERETT, WA 98201 ATTN: CHUCK ROBERTS (425) 261-8888

TULALIP BROADBAND (CABLE) 2601 88TH ST NE QUIL CEDA VILLAGE, WA 98271 (360) 716-3277

VERIZON OSP ENGINEERING PO BOX 1003 EVERETT, WA 98200 ATTN: TIM RENNICK (425) 263-4034

OWNER:

THE TULALIP TRIBES 8802 27TH AVE NE (360) 716-5024

GOVERNING AGENCY CONTACTS:

TULALIP TRIBES CONSOLIDATED BOROUGH OF QUIL CEDA VILLAGE 8802 27TH AVE NE TULALIP, WA 98271 (360) 716-5024 CONTACT: DEBRA BRAY

TULALIP TRIBES COMMUNITY DEVELOPMENT 6406 MARINE DR. TULALIP, WA 98271 (360) 716-4011 (360) 716-4209 CONTACT: GUS TAYLOR, AMANDA HUNTER SNOHOMISH COUNTY PUBLIC UTILITIES DISTRICT (PUD) 210 E DIVISION STREET ARLINGTON, WA 98223 ATTN: NICK FADICH (360) 435-7500

TULALIP DATA SERVICES 2601 88TH ST NE TULALIP, WA 98271 ATTN: TRAVIS HILL (360) 716-5128

PUGET SOUND ENERGY (GAS) PO BOX 97034 BELLEVUE, WA 98004 ATTN: JEANNE COLEMAN (425) 463-6550

ENGINEER:

PARAMETRIX 719 2ND AVENUE, SUITE 200 SEATTLE, WA 98104 ATTN: HAPPY LONGFELLOW (206) 394-3649

TULALIP TRIBES TRIBAL EMPLOYMENT RIGHTS OFFICE 6406 MARINE DR. TULALIP, WA 98271 (360) 716-4744



U.S.B.I.A. REGION

NORTHWEST

RESERVATION

IRR ROUTE 1090 SECTION 810 SCHEDULE A

IRR ROUTE 1091 SECTION 810 SCHEDULE B

IRR ROUTE 1092 SECTION 810 SCHEDULE C

IRR ROUTE 1093 SECTION 810 SCHEDULE D

IRR ROUTE 0053 SECTION 810 SCHEDULE F

TULALIP

IRR ROUTE 1094 SECTION 810

STATE

WA

SHEET No.

REVISIONS R. CUSHMAN J. JUN T. SMITH APPROVED H. LONGFELLOW

ONE INCH AT FULL SCALE F NOT, SCALE ACCORDINGL 1598089P01T02G-01 554-1598-089 T01 P02





SILVER VILLAGE PAVEMENT PRESERVATION AND PEDESTRIAN IMPORVEMENTS THE TULALIP TRIBES

TULALIP, WA

TITLE SHEET, LOCATION AND **VICINITY MAPS**

1 OF 32

G1

INDEX TO DRAWINGS							
SHT NO.	DWG NO.	SHEET TITLE					
1 2 3	G1 G2 G3	TITLE SHEET, LOCATION AND VICINITY MAPS INDEX TO DRAWINGS AND BID SCHEDULE GENERAL NOTES, LEGEND AND ABBREVIATIONS					
4 5 6 7 8 9 10 11 12	DM1 DM2 DM3 DM4 DM5 DM6 DM7 DM8 DM9	DEMOLITION, SITE PREPARATION, TESC AND UTILITY ADJUSTMENTS					
13 14 15 16	RS1 RS2 RS3 RS4	TYPICAL ROADWAY SECTIONS TYPICAL ROADWAY SECTIONS TYPICAL ROADWAY SECTIONS TYPICAL ROADWAY SECTIONS					
17 18 19 20 21 22 23 24 25 26	CH1 CH2 CH3 CH4 CH5 CH6 CH7 CH8 CH9 CH10	CHANNELIZATION, SIGNING AND PAVING PLAN LINE AND CURVE TABLES, SIGN SCHEDULES					
27 28	DT1 DT2	DETAILS DETAILS					
29 30	S1 S2	MAINTENANCE BUILDING ROLLER GATE PAD BUS SHELTER CONCRETE BASE PAD					
31 32	TC1 TC2	TEMPORARY TRAFFIC CONTROL PLAN TEMPORARY TRAFFIC CONTROL PLAN					

與關係	的现在分词形式		Sched A		Sched C	Sched D	Sched E	Sched F	TOTAL	
ITEM#	ITEM DESCRIPTION	UNIT	QTY	QTY	QTY	QTY	QTY	QTY	Total	
1	Mobilization	LS	1.0	1.0	1.0	1.0	1.0	1.0	1	
2	Clearing and Grubbing and Roadside Cleanup	ACRE	0.4	0.3	0.2	0.1	0.2	0.0	1	
3	Removing Asphalt Conc. Pavement	SY	88	784	438	73	388	0	17	
4	Remove Chain Link Fence/Posts	LF	80	0	0	0	0	0		
5	Remove, Salvage and Reset Chain Link Gate	EACH	2.0	0.0	0.0	0.0	0.0	0.0	2	
6	Remove Existing Culvert	LF	158	64	0	0	46	0	2	
7	Roadway Excavation Incl. Haul	CY	281	511	54	0	10	509	13	
8	Select Borrow Incl. Haul	CY	100	0	0	0	0	0	1	
9	Quarry Spalls	CY	2	0	0	0	0	0		
10	Schedule A Culv. Pipe 12 IN. DIA	LF	108	61	0	0	46	0	2	
11	Catch Basin Type 1L	EACH	2.0	0.0	0.0	0.0	0.0	0.0		
12	Catch Basin Type 1	EACH	9.0	0.0	0.0	0.0	0.0	0.0	1	
13	Catch Basin Type 2-48" DIA	EACH	1.0	0.0	0.0	0.0	1.0	0.0		
14	Schedule A Storm Sewer Pipe 12 IN. DIA	L.F.	371	0	0	0	0	0	3	
16	Schedule A Storm Sewer Pipe 18 IN. DIA	LF	131	0	0	0	0	0	1	
17	Testing Storm Sewer Pipe Crushed Surfacing Top Course	LF	510	0	0	0	0	0		
18		TON	51	716	170	70	325	0	13	
19	Crushed Surfacing Base Course HMA CL. 1/2 IN. PG 64-22	TON	292	1256	264	127	177	195	23	
20	Planing Bituminous Pavement	TON	353	1276	659	192	572	356	34	
21	Roadway Pulverization and Grading	SY	0	0	0	0	0	1430	14	
22	Longitudinal Joint Seal	SY	1335	3334	1711	822	1149	0	8	
23	Crack Sealing - FA	EST.	230	604	390	210	400	80	19	
24	Erosion/Water Pollution Control	EST.	1.0	1 0	1	0	1	0		
25	Topsoil Type A	SY	425	1.0	1.0	1.0	1.0	1.0		
26	WATTLE	LF	0	466	396	0	0	0	-	
27	Inlet Protection	EA	0	0	390	0	0	0		
28	ESC LEAD	DAY	6	6	6	6	6	5		
29	Seeding and Fertilizing by Hand	SY	425.0	0.0	0.0	0.0	0.0	0.0	42	
30	Mulch	SY	425.0	0.0	0.0	0.0	0.0	0.0	42	
31	Cement Conc. Traffic Curb and Gutter	LF	468	0.0	0.0	0.0	0.0	0.0	42	
32	Paint Line	LF	210	0	0	0	0	0		
33	Painted Stop Line	LF	0	30	20	0	0	0		
34	Permanent Signing	LS	1.0	1.0	1.0	1.0	1.0	1.0		
35	Project Temporary Traffic Control	LS	1.0	1.0	1.0	1.0	1.0	1.0		
36	Structure Excavation Class B INCL. Haul	CY	419	38	0	0	3	0		
37	Cement Conc. Sidewalk	SY	147	0	0	0	0	0		
38	Cement Conc. Curb Ramp Type Single Direction	EACH	1.0	0.0	0.0	0.0	0.0	0.0		
39	Cement Conc. Curb Ramp Type Parallel Type A	EACH	1.0	0.0	0.0	0.0	0.0	0.0		
40	Cement Conc. Curb Ramp Type Parallel Type B	EACH	3.0	0.0	0.0	0.0	0.0	0.0		
41	Cement Conc. Driveway Entrance Type 1	SY	102	0	0	0	0	0		
42	Adjust Valve Box	EACH	3.0	2.0	1.0	1.0	2.0	0.0		
43	Adjust Catch Basin	EACH	0.0	0.0	0.0	0.0	0.0	4.0		
44	Adjust Manhole	EACH	2.0	10.0	2.0	0.0	2.0	3.0	1	
45	Bench	EACH	1.0	0.0	0.0	0.0	0.0	0.0		
46	Bus Shelter	EACH	1.0	0.0	0.0	0.0	0.0	0.0		
47	Bus Shelter Concrete Base Pad	EACH	1.0	0.0	0.0	0.0	0.0	0.0		
48	Maintenance Building Roller Gate Pad	EACH	1.0	0.0	0.0	0.0	0.0	0.0		
49	Speed Hump	EACH	0.0	3.0	1.0	0.0	2.0	0.0		
50	Pothole Existing Utilities	EST	1.0	0.0	0.0	0.0	0.0	0.0		
51	Minor Change	EST	0.2	0.2	0.2	0.1	0.2	0.1		
52	Chain Link Fence Type 3	LF	79	0	0	0	0	0		
53	End. Gate, Corner and Pull Posts	EACH	5.0	200	200	0.0	0.0	00		
54	Removing Drainage Structure	EACH	0.0	0.0	0.0	0.0	1.0	0.0	· ·	
55	Controlled Density Fill	CY	0.0	38.0	0.0	0.0	0.0	0.0	38	

Cohed A Cohed D Cohed C Cohed D Cohed C Cohed

	REVISIONS	DATE	BY	DESIGNED R. CUSHMAN
1	PER REVIEW COMMENTS	7/25/16	RSC	DRAWN
2	PER COTERRA	7/29/16	RSC	J. JUN
				T. SMITH
				APPROVED H. LONGFELLOW

ONE INCH AT FULL SCALE.
IF NOT, SCALE ACCORDINGLY
FILE NAME
PS1598089P01T02G-01
JOB No.
554-1598-089 T01 P02
DATE
JUNE 2016



Parametrix
ENGINEERING, PLANNING, ENVIRONMENTAL SCIENCES

719 2ND AVENUE, SUITE 200 | SEATTLE, WA 98104
P 206.394.3700
WWW.PARAMETRIX.COM

PROJECT NAME

SILVER VILLAGE PAVEMENT PRESERVATION AND PEDESTRIAN IMPORVEMENTS THE TULALIP TRIBES

TULALIP, WA

INDEX TO DRAWINGS AND BID SCHEDULE

Know what's below.
Call before you dig.


SHEET NO. 2 OF 32

G2

APPD APPROVED APPROX,~ APPROXIMATE ARV AIR RELEASE VALVE ASB ASBESTOS ASPH ASPHALT ASSY ASSEMBLY AVE AVENUE AVG AVERAGE BC BEGINNING OF CURVE, BOLT CIRCLE BCR BEGINNING OF CURVE CENTER BET BETWEEN BF BLIND FLANGE BFG BIOCELL FINISHED GRADE BLOW BULDING BLVD BOULEVARD BM BEAM, BENCH MARK BO BLOW OFF BOT BOTTOM BRG BEARING BUV BUTTERFLY VALVE BVC BEGIN VERTICAL CURVE BOW BACK OF WALK CAP CAPACITY CB CATCH BASIN CCP CONCRETE LINED AND COATED STEEL PIF CCW COUNTER CLOCKWISE COF CONTROLLED DENSITY FILL CEM CEMENT CHV CHECK VALVE CI CAST IRON CIP CAST IN PLACE, CAST IRON PIPE CIC CICCLE CJ CONSTRUCTION JOINT CLR CLEAR, CLEARANCE CMP CORRUGATED METAL PIPE CMU CONCRETE CYLINDER CONCRETE CYLINDER CONCRETE CYLINDER CIP CAST IN PLACE, CAST IRON PIPE CIP CAST IN PLACE, CAST IRON PIPE CIP CONCRETE CYLINDER CONCRETE CYLINDER CONCRETE CYLINDER CONCRETE CYLINDER CONCRETE CYLINDER CONCRETE CONTROLLED CONCRETE CONCRETE CONTROLLED CONCRETE CONC	FC FCA FCR FG FH FIG FIN FL	FLEXIBLE CONNECTION FLANGE COUPLING ADAPTER
ARV AIR RELEASE VALVE ASB ASSESTOS ASPH ASPHALT ASSY ASSEMBLY AVE AVENUE AVG AVERAGE BC BEGINNING OF CURVE, BOLT CIRCLE BCR BEGINNING OF CURVE CENTER BET BETWEEN BF BLIND FLANGE BLOB BULDING BLVD BOULEVARD BM BEAM, BENCH MARK BO BLOW OFF BOT BOTTOM BRG BEARING BUV BUTTERFLY VALVE BVC BEGIN VERTICAL CURVE BOW BACK OF WALK CAP CAPACITY CB CATCH BASIN CCP CONTROLLED DENSITY FILL CEM CEMENT CHY CHECK VALVE CI CAST IN PLACE, CAST IRON PIPE CIR CIECLE CJ CONSTRUCTION JOINT CLR CLEAR, CLEARANCE CMP CONCRETE CONTINUOUS CONDUIT COD CONDUIT CO COUNTY, CLEANOUT COMM COMMUNICATIONS CONC CONCRETE CONS CONCRETE CONS CONCRETE COND CONTROLLED COM CONTROLLED COM CONSTRUCTION JOINT CLR CLEAR, CLEARANCE CMP CORRUGATED METAL PIPE CMU CONCRETE MASONRY UNIT CND CONDUIT CO COUNTY, CLEANOUT COMM COMMUNICATIONS CONC CONCRETE CONS CONCRETE CONS CONSTRUCTION CONSTRUCT, CONSTRUCTION CONST CONSTRUCT, CONSTRUCTION CONT CONTROLTO, CONSTRUCTION CONT CONTROLTO, CONSTRUCTION CONT CONTROLT, CONSTRUCTION CONT CONTROLTO, CONSTRUCTION COTG CLEAN OUT TO GROUND CPLG COUPLING CSBC CRUSHED SURFACING BASE COURSE CSC CRUSHED SURFACING TOP COURSE CTR CENTER CULV CULVERT CV CONTROL VALVE CY CUBIC YARD DEPTH, DENSITY, DRAIN, DRAINAGE DEFOLD DEMOLITION	FCR FG FH FIG FIN	FLANGE COUPLING ADAPTER
ARV AIR RELEASE VALVE ASB ASBESTOS ASPH ASPHALT ASSY ASSEMBLY AVE AVENUE AVG AVERAGE BC BEGINNING OF CURVE, BOLT CIRCLE BCR BEGINNING OF CURVE CENTER BET BETWEEN BF BLIND FLANGE BHOCELL FINISHED GRADE BLUD BOULEVARD BM BEAM, BENCH MARK BO BLOW OFF BOT BOTTOM BRG BEARING BUV BUTTERFLY VALVE BVC BEGIN VERTICAL CURVE BOW BACK OF WALK CAP CAPACITY CB CATCH BASIN CCP CONCRETE CYLINDER PIPE CCSP CONCRETE CYLINDER PIPE CCW COUNTER CLOCKWISE COF CONTROLLED DENSITY FILL CEM CEMENT CHY CHECK VALVE CI CAST IN PLACE, CAST IRON PIPE CIR CIRCLE CJ CONSTRUCTION JOINT CLR CLEAR, CLEARANCE CMP CONCRETE CMP CONCRETE CMP CONCRETE CONDUIT CONDUIT CON CONSTRUCTION CONDUIT CON CONSTRUCTION CONDUIT CON CONNETT CON CONSTRUCTION CONNETT CONDUIT CON CONNETT CON CONSTRUCTION CONTROLLED CONCRETE COND CONDUIT CON CONSTRUCTION CONTROLTON CONTROL VALVE CY CUBIC YARD DEPTH, DENSITY, DRAIN, DRAINAGE DEGE DEMO DEMOLITION	FG FH FIG FIN	TIME ORLIGHED BOOK
ASPH ASPH ASSY ASSEMBLY AVE	FH FIG FIN	FINE CRUSHED ROCK
ASSY ASSEMBLY AVE AVENUE AVENUE AVENUE BC BEGINNING OF CURVE, BOLT CIRCLE BER BEGINNING OF CURVE CENTER BET BETWEEN BF BLIND FLANGE BFG BIOCELL FINISHED GRADE BLDG BUILDING BLUD BOULEVARD BM BEAM, BENCH MARK BO BLOW OFF BOT BOTTOM BRG BEARING BUV BUTTERFLY VALVE BVC BEGIN VERTICAL CURVE BOW BACK OF WALK CAP CAPACITY CB CATCH BASIN CCP CONCRETE CYLINDER PIPE CCCW COUNTER CLOCKWISE COF CONTROLLED DENSITY FILL CEM CEMENT CHY CHECK VALVE CI CAST IRON CIP CAST IN PLACE, CAST IRON PIPE CICIP CONCRETE CONTROLLED DENSITY FILL COMMUNICATIONS CONC CONCRETE COMP CONCRETE COMP CONCRETE CONDITION CONNET CONSTRUCTION CONCRETE COND CONDUIT CONCRETE COND CONDUIT CONCRETE COND CONDUITO CONCRETE CONTROLLED CONCRETE CONCRET	FIG FIN	FINISH GRADE
ASSY ASSEMBLY AVE AVENUE AVENUE AVENUE BC BEGINNING OF CURVE, BOLT CIRCLE BER BEGINNING OF CURVE CENTER BET BETWEEN BF BLIND FLANGE BFG BIOCELL FINISHED GRADE BLDG BUILDING BLUD BOULEVARD BM BEAM, BENCH MARK BO BLOW OFF BOT BOTTOM BRG BEARING BUV BUTTERFLY VALVE BVC BEGIN VERTICAL CURVE BOW BACK OF WALK CAP CAPACITY CB CATCH BASIN CCP CONCRETE CYLINDER PIPE CCCW COUNTER CLOCKWISE COF CONTROLLED DENSITY FILL CEM CEMENT CHY CHECK VALVE CI CAST IRON CIP CAST IN PLACE, CAST IRON PIPE CICIP CONCRETE CONTROLLED DENSITY FILL COMMUNICATIONS CONC CONCRETE COMP CONCRETE COMP CONCRETE CONDITION CONNET CONSTRUCTION CONCRETE COND CONDUIT CONCRETE COND CONDUIT CONCRETE COND CONDUITO CONCRETE CONTROLLED CONCRETE CONCRET	FIG FIN	FIRE HYDRANT
AVE AVENUE AVE AVERAGE BC BC BC BEGINNING OF CURVE, BOLT CIRCLE BCR BEGINNING OF CURVE CENTER BET BET BET BETWEEN BF BLIND FLANGE BBFG BIOCELL FINISHED GRADE BLVD BULDING BLVD BULEVARD BM BEAM, BENCH MARK BD BLOW OFF BOT BOTTOM BRG BEARING BUV BUTTERFLY VALVE BWC BEGIN VERTICAL CURVE BOW BACK OF WALK CAP CAPACITY CB CATCH BASIN CCP CONCRETE CYLINDER PIPE CCCW COUNTER CLOCKWISE COF CONTROLLED DENSITY FILL CEME CEMENT CHECK VALVE CI CAST IN PLACE, CAST IRON PIPE CIC CAST IN PLACE, CAST IRON PIPE CIC CIRCLE CJ CONSTRUCTION JOINT CLE CLEAR, CLEARANCE CMP CONTROLLED METAL PIPE COMU CONCRETE MASONRY UNIT COND CONDUIT CON CONDUIT CONCRETE COMD CONDUIT CONCRETE COND CONDUIT CONCRETE COND CONDUIT CONCRETE COND CONDUIT CONCRETE COND CONDUIT CONCRETE CONSTRUCTION CONNECT, CONSTRUCTION CONDUIT CONCRETE COND CONDUITO CONSTRUCT, CONSTRUCTION CONTRACTOR COTTACTOR COTTACT	FIN	FIGURE
AVG AVERAGE BC BEGINNING OF CURVE, BOLT CIRCLE BCR BEGINNING OF CURVE CENTER BET BETWEEN BF BLIND FLANGE BFG BIOCELL FINISHED GRADE BLOB BUILDING BLUD BOULEVARD BM BEAM, BENCH MARK BO BLOW OFF BOT BOTTOM BRG BEARING BUV BUTTERFLY VALVE BWC BEGIN VERTICAL CURVE BOW BACK OF WALK CAP CAPACITY CB CATCH BASIN CCP CONCRETE CYLINDER PIPE CCSP CONCRETE LINED AND COATED STEEL PIF CCW COUNTER CLOCKWISE COF CONTROLLED DENSITY FILL CEM CEMENT CHY CHECK VALVE CI CAST IRON CIP CAST IN PLACE, CAST IRON PIPE CIR CIRCLE CJ CONSTRUCTION JOINT CLR CLEAR, CLEARANCE CMP CORRUGATED METAL PIPE CMU CONCRETE MASONRY UNIT COND CONDIT CONDUIT CON CONCRETE CON CONTROLLED ON TORSE CONC CONSTRUCTION CONCRETE COND CONCRETE COND CONCRETE COND CONCRETE COND CONSTRUCTION CONSTRUCT, CONSTRUCTION CONSTRUCT CONCRUGATION CONCRUGATION CONCRUGATION CONCRUGATION CONCRUGATION CONCRUGATION CONCR		FINISH, FINISHED
BC BEGINNING OF CURVE, BOLT CIRCLE BCR BEGINNING OF CURVE CENTER BET BETWEEN BF BLIND FLANGE BFG BIOCELL FINISHED GRADE BLDG BUILDING BLVD BOULEVARD BM BEAM, BENCH MARK BO BLOW OFF BOT BOTTOM BRG BEARING BUV BUTTERFLY VALVE BVC BEGIN VERTICAL CURVE BOW BACK OF WALK CAP CAPACITY CB CATCH BASIN CCP CONCRETE CYLINDER PIPE CCCW COUNTER CLOCKWISE COF CONTROLLED DENSITY FILL CEM CEMENT CHV CHECK VALVE CI CAST IRON CIP CAST IN PLACE, CAST IRON PIPE CIP CONCRETE CONTROLLED DENSITY FILL CEM CEMENT CHV CHECK VALVE CI CAST IN PLACE, CAST IRON PIPE CIP CAST IN PLACE, CAST IRON PIPE COMP CONCRETE MASONRY UNIT COND CONDITION CONCRETE MASONRY UNIT COND CONDITION CONCRETE CONCRETE CONTROLLED CONCRETE CONTROLLED CONCRETE CONTROLLED CONCRETE CONCRET		FLOW LINE
BECR BEGINNING OF CURVE CENTER BET BETWEEN BF BLIND FLANGE BFG BIOCELL FINISHED GRADE BLDG BULDING BLUD BOULEVARD BM BEAM, BENCH MARK BO BLOW OFF BOT BOTTOM BRG BEARING BUV BUTTERFLY VALVE BWC BEGIN VERTICAL CURVE BWO BACK OF WALK CAP CAPACITY CB CAPACITY CC CONCRETE CYLINDER PIPE CCCY CONTROLLED DENSITY FILL CEM CEMENT CHY CHECK VALVE CI CAST IN PLACE, CAST IRON PIPE CIC CIRCLE CJ CONSTRUCTION JOINT CLE CLEAR, CLEARANCE CMP CONCRETE CONDITION CONDUIT CON CONNECTE MASONRY UNIT COND CONDUIT CON CONNECTE CONNECTION CONNECTE CONSTRUCTION CONTRACTOR COTRACTOR COTRACTO		
BET BETWEEN BF BLIND FLANGE BFG BIOCELL FINISHED GRADE BLUD BUILDING BLVD BOULEVARD BM BEAM, BENCH MARK BO BLOW OFF BOT BOTTOM BRG BEARING BUV BUTTERFLY VALVE BVC BEGIN VERTICAL CURVE BOW BACK OF WALK CAP CAPACITY CB CATCH BASIN CCP CONCRETE CYLINDER PIPE CCCW COUNTER CLOCKWISE CDF CONTROLLED DENSITY FILL CEM CEMENT CHY CHECK VALVE CI CAST IN PLACE, CAST IRON PIPE CIR CIRCLE CJ CONSTRUCTION JOINT CLR CLEAR, CLEARANCE CMP CORRUGATED METAL PIPE CNU CONCRETE MASONRY UNIT CND CONDUIT CON CONDUIT CON CONNETT CON CONNETT COND CONDITION CONDITION CONDITION CONNET CONNECTION CONNECT, CONSTRUCTION CONSTRUCTION CONNECT, CONSTRUCTION CONSTRUCT, CONSTRUCTION CONNECT, CONSTRUCTION CONSTRUCT, CONSTRUCTION CONSTRUCT, CONSTRUCTION CONST CONNECT, CONSTRUCTION CONST CONNECT, CONSTRUCTION CONST CONSTRUCT, CONSTRUCTION CONT CONTRACTOR COTT CONTRACTOR COTT CONTRACTOR COTT CONTRACTOR COTT CORRUGATED, CORRUGATION CONT CONTRACTOR COTT C	FLEX	FLEXIBLE
BF BLIND FLANGE BFG BIOCELL FINISHED GRADE BLOB BUILDING BLVD BOULEVARD BM BEAM, BENCH MARK BO BLOW OFF BOT BOTTOM BRG BEARING BUV BUTTERFLY VALVE BVC BEGIN VERTICAL CURVE BOW BACK OF WALK CAP CAPACITY CB CATCH BASIN CCP CONCRETE CYLINDER PIPE CCSP CONCRETE CYLINDER PIPE CCSP CONTROLLED DENSITY FILL CEM CEMENT CHV CHECK VALVE CI CAST IRON CIP CAST IN PLACE, CAST IRON PIPE CIP CAST IN PLACE, CAST IRON PIPE CIP CONSTRUCTION JOINT CLE CLEAR, CLEARANCE CMP CORRUGATED METAL PIPE CMU CONCRETE MASONRY UNIT CND CONDUIT COD CONUTY, CLEANOUT COMMUNICATIONS CONC CONCRETE COND CONDUITO CON CONCRETE COND CONSTRUCTION CONSTRUCTION JOINT COND CONDUIT COM COMMUNICATIONS CONC CONCRETE COND CONSTRUCTION CONSTRUCT, CONSTRUCTION CONSTRUCTORY CONTRUCTORY CONTRUCT	FLG	FLANGE, FLANGED
BFG BIOCELL FINISHED GRADE BLDG BUILDING BLDG BUILDING BM BEAM, BENCH MARK BD BLOW OFF BOT BOTTOM BRG BEARING BUV BUTTERFLY VALVE BWC BEGIN VERTICAL CURVE BWC BEGIN VERTICAL CURVE BOW BACK OF WALK CAP CAPACITY CB CATCH BASIN CCP CONCRETE CYLINDER PIPE CCW COUNTER CLOCKWISE COF CONTROLLED DENSITY FILL CEM CEMENT CHV CHECK VALVE CI CAST IN PLACE, CAST IRON PIPE CIP CAST IN PLACE, CAST IRON PIPE CIP CONCRETE CONTROLLED DENSITY FILL CEM CEMENT CHY CHECK VALVE CI CAST IN PLACE, CAST IRON PIPE CIP CAST IN PLACE, CAST IRON PIPE CIP CONSTRUCTION JOINT CLE CLEAR, CLEARANCE CUP CONSTRUCTION JOINT CON CONCRETE MASONRY UNIT COD CONDUIT CON CONCRETE COND CONDUITO CONNECT, CONNECTION CONNECT, CONSTRUCTION CONNECT, CONSTRUCTION CONNECT, CONSTRUCTION CONSTRUCT, CONSTRUCTION CONSTRUCT, CONSTRUCTION CONSTRUCT, CONSTRUCTION CONTRACTOR CORT CORREGATED, CORRUGATION COTTACTOR CORRECT CORRUGATED, CORRUGATION CONTRACTOR CORRECT CORRUGATED, CORRUGATION CONTRACTOR CORRECT CORRUGATION CONTRACTOR CORRECT CONTRACTOR CORRECT CONTRACTOR CORRECT CONTRACTOR CONT	FM	FORCE MAIN
BLDG BLVD BULEVARD BM BEAM, BENCH MARK BD BD BD BD BD BOT BOTTOM BRG BEARING BUV BUTTERFLY VALVE BVC BEGIN VERTICAL CURVE BOW BACK OF WALK CAP CAPACITY CB CATCH BASIN CCP CONCRETE CYLINDER PIPE CCCW COUNTER CLOCKWISE COF CONTROLLED DENSITY FILL CEM CEMENT CHY CHECK VALVE CI CAST IN PLACE, CAST IRON PIPE CICI CICI CAST IN PLACE, CAST IRON PIPE CICI CICI CAST IN PLACE, CAST IRON PIPE CICI CIRCLE CJ CONSTRUCTION JOINT CLEAR, CLEARANCE CMP CORRUGATED METAL PIPE CMU CONCRETE MASONRY UNIT COND CONDUIT CON CONNETT COND CONNETT CONTROLLED CONCRETE COND CONCRETE COND CONCRETE COND CONCRETE COND CONCRETE COND CONCRETE CONC CONTROLLOR CONTROLTON CON	FPC	FLEXIBLE PIPE COUPLING
BLVD BOULEVARD BM BEAM, BENCH MARK BO BLOW OFF BOT BOTTOM BRG BEARING BUV BUTTERFLY VALVE BWC BEGIN VERTICAL CURVE BOW BACK OF WALK CAP CAPACITY CB CATCH BASIN CCP CONCRETE CYLINDER PIPE CCSP CONCRETE LINED AND COATED STEEL PIP CCCW COUNTER CLOCKWISE COF CONTROLLED DENSITY FILL CEM CEMENT CHY CHECK VALVE CI CAST IRON CIP CAST IN PLACE, CAST IRON PIPE CIR CIRCLE CJ CONSTRUCTION JOINT CLR CLEAR, CLEARANCE CMP CORRUGATED METAL PIPE CMU CONCRETE MASONRY UNIT COMD CONDUIT COM CONNECT, CONNECTION CONST CONSTRUCTION CONST CONSTRUCT, CONSTRUCTION CONST CONTRACTOR CORRUGATED, CORRUGATION CONTE CONTRACTOR CONTROCTOR	FRP	FIBERGLASS REINFORCED PLASTIC
BEAM, BENCH MARK BO BLOW OFF BOT BOTTOM BRG BEARING BUV BUTTERFLY VALVE BVC BEGIN VERTICAL CURVE BOW BACK OF WALK CAP CAPACITY CB CATCH BASIN CCCP CONCRETE CYLINDER PIPE CCCSP CONCRETE LINED AND COATED STEEL PIP CCCW COUNTER CLOCKWISE CDF CONTROLLED DENSITY FILL CEM CEMENT CHV CHECK VALVE CI CAST IRON CIP CAST IN PLACE, CAST IRON PIPE CICIP CAST IN PLACE, CAST IRON PIPE CICIP CAST IN PLACE, CAST IRON PIPE CICIP CIRCLE CJ CONSTRUCTION JOINT CLE CLEAR, CLEARANCE CMP CORRUGATED METAL PIPE CMU CONCRETE MASONRY UNIT CND CONDUIT COM COMMUNICATIONS CONC CONCRETE COND CONDITION CONSTRUCT, CONSTRUCTION CONSTRUCT, CONSTRUCT, CONSTRUCTION CONSTRUCT, CONSTRUC	FT	FEET, FOOT
BOO BLOW OFF BOT BOTTOM BRG BEARING BUV BUTTERFLY VALVE BWC BEGIN VERTICAL CURVE BWO BACK OF WALK CAP CAPACITY CB CAPACITY CCSP CONCRETE CYLINDER PIPE CCCSP CONTROLLED DENSITY FILL CCCCW COUNTER CLOCKWISE CDF CONTROLLED DENSITY FILL CCCC COUNTER CLOCKWISE CIC CAST IRON CIP CAST IN PLACE, CAST IRON PIPE CIC CAST IN PLACE, CAST IRON PIPE CIC CIRCLE CJ CONSTRUCTION JOINT CLR CLEAR, CLEARANCE CMP CORRUGATED METAL PIPE CMU CONCRETE MASONRY UNIT COND CONDUIT CON CONNECT, CONSECTION CONNECT, CONSTRUCTION CONNECT, CONSTRUCTION CONSTRUCT, CONSTRUCTION CONSTRUCT, CONSTRUCTION CONTRACTOR COTTACTOR CO	FUT	FUTURE
BOO BLOW OFF BOT BOTTOM BRG BEARING BUV BUTTERFLY VALVE BWC BEGIN VERTICAL CURVE BWO BACK OF WALK CAP CAPACITY CB CAPACITY CCSP CONCRETE CYLINDER PIPE CCCSP CONTROLLED DENSITY FILL CCCCW COUNTER CLOCKWISE CDF CONTROLLED DENSITY FILL CCCC COUNTER CLOCKWISE CIC CAST IRON CIP CAST IN PLACE, CAST IRON PIPE CIC CAST IN PLACE, CAST IRON PIPE CIC CIRCLE CJ CONSTRUCTION JOINT CLR CLEAR, CLEARANCE CMP CORRUGATED METAL PIPE CMU CONCRETE MASONRY UNIT COND CONDUIT CON CONNECT, CONSECTION CONNECT, CONSTRUCTION CONNECT, CONSTRUCTION CONSTRUCT, CONSTRUCTION CONSTRUCT, CONSTRUCTION CONTRACTOR COTTACTOR CO	FOW	FRONT OF WALK
BOTT BOTTOM BRG BEARING BUV BUTTERFLY VALVE BUV BUTTERFLY VALVE BUV BEGIN VERTICAL CURVE BOW BACK OF WALK CAP CAPACITY CB CATCH BASIN CCP CONCRETE CYLINDER PIPE CCSP CONCRETE LINED AND COATED STEEL PIF CCCW COUNTER CLOCKWISE CDF CONTROLLED DENSITY FILL CEM CEMENT CHV CHECK VALVE CI CAST IRON CIP CAST IN PLACE, CAST IRON PIPE CIR CIRCLE CJ CONSTRUCTION JOINT CLE CLEAR, CLEARANCE CMP CORRUGATED METAL PIPE CMU CONCRETE MASONRY UNIT COD COUNTY, CLEANOUT COMM COMMUNICATIONS CONC CONCRETE COND CONDITION CONST CONSTRUCTION CONST CONSTRUCT, CONSTRUCTION CONSTRUCT, CONSTRUCTOR CONSTRUCT, CONSTRUCTOR CONSTRUCT, CONSTRUCT	G	GAS
BRG BEARING BUV BUTTERFLY VALVE BVC BEGIN VERTICAL CURVE BOW BACK OF WALK CAP CAPACITY CB CATCH BASIN CCP CONCRETE CYLINDER PIPE CCSP CONCRETE LINED AND COATED STEEL PIF CCCW COUNTER CLOCKWISE CDF CONTROLLED DENSITY FILL CEM CEMENT CHV CHECK VALVE CI CAST IRON CIP CAST IN PLACE, CAST IRON PIPE CIR CIRCLE CJ CONSTRUCTION JOINT CLR CLEAR, CLEARANCE CMP CORRUGATED METAL PIPE CMU CONCRETE MASONRY UNIT CND CONDUIT COO COUNTY, CLEANOUT COMMUNICATIONS CONC CONCRETE COND CONSTRUCTION CONTRACTOR CORRUGATED, CORRUGATION CONTRACTOR CORRUGATED, CORRUGATION CONTRACTOR CORRUGATED, CORRUGATION CONTRACTOR CORRUGATED, CORRUGATION CONTRACTOR CONTRACTOR CORRUGATED, CORRUGATION CONTRACTOR CORRUGATED, CORRUGATION CONTRACTOR CONTRACTOR CORRUGATED, CORRUGATION CONTRACTOR CONTRACTOR CORRUGATED, CORRUGATION CONTRACTOR CONTRACTOR CORRUGATED, CORRUGATION CONTRACTOR CONTROL VALVE CULVERT COULV CULVERT COULV CULVERT COULV CULVERT COULV CULVERT COULV CULVERT CONTROL VALVE CULVERT CONTROL VALVE CUBIC YARD DEPTH, DENSITY, DRAIN, DRAINAGE DEGREE DEMO DEMOLITION	GALV	GALVANIZED
BUTTERFLY VALVE BYC BEGIN VERTICAL CURVE BOW BACK OF WALK CAP CAPACITY CB CATCH BASIN CCP CONCRETE CYLINDER PIPE CCW COUNTER CLOCKWISE CDF CONTROLLED DENSITY FILL CEM CEMENT CHY CHECK VALVE CI CAST IN PLACE, CAST IRON PIPE CIP CONSTRUCTION JOINT CLE CLEAR, CLEARANCE CMP CONGRETE MASONRY UNIT CND CONDUIT CON CONCRETE COND CONDUIT CONTROLLED DENSITY FILL CONDUITON CONNECT, CONSTRUCTION CONNECT, CONSTRUCTION CONNECT, CONSTRUCTION CONSTRUCT, CONSTRUCTION CONSTRUCT, CONSTRUCTION CONSTRUCT, CONSTRUCTION CONSTRUCT, CONSTRUCTION CONTROLLED CONTROLLED CONTROLLED CONTROLLED CONTROLLED CONTROLLED CONCRETE CONCRETE CONCRETE CONCRETE CONCRETE CONCRETE CONTROLLED CONTROLLE	GC	GROOVED COUPLING
BEGIN VERTICAL CURVE BOW BACK OF WALK CAP CAPACITY CB CATCH BASIN CCP CONCRETE CYLINDER PIPE CCSP CONCRETE LINED AND COATED STEEL PIF CCCW COUNTER CLOCKWISE CDF CONTROLLED DENSITY FILL CEM CEMENT CHECK VALVE CI CAST IN PLACE, CAST IRON PIPE CIC CIRCLE CINCLE CIRCLE CONSTRUCTION JOINT CLEAR, CLEARANCE CMP CORRUGATED METAL PIPE CMU CONCRETE MASONRY UNIT CONDUIT CONDUIT CONDUIT CONNETTE CONSTRUCTION CONNETTE COND CONDITION CONNETTE COND CONSTRUCT, CONSTRUCTION CONSTITUCT, CONSTRUCTION CONTRACTOR COTTACTOR COTTACTO		
BOW BACK OF WALK CAP CAPACITY CB CATCH BASIN CCP CONCRETE CYLINDER PIPE CCSP CONCRETE LINED AND COATED STEEL PIF CCCW COUNTER CLOCKWISE CDF CONTROLLED DENSITY FILL CEM CEMENT CHY CHECK VALVE CI CAST IRON CIP CAST IN PLACE, CAST IRON PIPE CIR CIRCLE CJ CONSTRUCTION JOINT CLR CLEAR, CLEARANCE CMP CORRUGATED METAL PIPE CMU CONCRETE MASONRY UNIT COMD CONDUIT COMMUNICATIONS CONC CONCRETE COND CONTROLTION CONST CONSTRUCTION CONST CONSTRUCTION CONST CONSTRUCTION CONST CONSTRUCTION CONST CONSTRUCT, CONSTRUCTION CONST CONTRACTOR CORRUGATED, CORRUGATION CONTRACTOR CONTROCTOR CORRUGATED, CORRUGATION CONTRACTOR CONTROCTOR CORRUGATED, CORRUGATION CONTROCTOR CONTROCTO	GR	GRADE
CAPACITY CB CATCH BASIN CCCP CONCRETE CYLINDER PIPE CCSP CONCRETE LINED AND COATED STEEL PIP CCCW COUNTER CLOCKWISE CDF CONTROLLED DENSITY FILL CEM CEMENT CHV CHECK VALVE CI CAST IRON CIP CAST IN PLACE, CAST IRON PIPE CIR CIRCLE CJ CONSTRUCTION JOINT CLR CLEAR, CLEARANCE CMP CORRUGATED METAL PIPE CMU CONCRETE MASONRY UNIT CND CONDUIT COO COUNTY, CLEANOUT COMMUNICATIONS CONC CONCRETE COND CONDITION CONSTRUCT, CONSTRUCTION CONSTRUCT CONST	GV	GATE VALVE
CB CATCH BASIN CCP CONCRETE CYLINDER PIPE CCSP CONCRETE LINED AND COATED STEEL PIR CCW COUNTER CLOCKWISE CDF CONTROLLED DENSITY FILL CEM CEMENT CHY CHECK VALVE CI CAST IRON CIP CAST IN PLACE, CAST IRON PIPE CIR CIRCLE CJ CONSTRUCTION JOINT CLE CLEAR, CLEARANCE CMP CORRUGATED METAL PIPE CMU CONCRETE MASONRY UNIT CND CONDUIT COONTY, CLEANOUT COMMUNICATIONS CONC CONCRETE COND CONDITION CONNECT, CONNECTION CONNECT, CONSTRUCTION CONSTRUCT, CONSTRUCTION CONSTRUCT, CONSTRUCTION CONTRACTOR CORRETE COND CONTRACTOR CORRETE CONT CORREGATED, CORRUGATION CONTRACTOR CORRETE CORREGATED, CORRUGATION CONTRACTOR CORRETE CONTRACTOR CORRESCANDED CONSTRUCT, CONSTRUCTION CONTRACTOR CORRESCANDED CONTRACTOR CORRESCANDED CONTRACTOR CORRESCANDED CORRESCANDED CORRESCANDED CORRESCANDED CORRESCANDED COUNTRACTOR CORRESCANDED CORRESCANDED CORRESCANDED COUNTRACTOR CORRESCANDED CORRESCANDED COUNTRACTOR CORRESCANDED COUNTRACTOR CORRESCANDED COUNTRACTOR CORRESCANDED COUNTRACTOR CORRESCANDED COUNTRACTOR CORRESCANDED COUNTRACTOR CONTRACTOR CORRESCANDED COUNTRACTOR CONTRACTOR C	HB	HOSE BIBB
CCP CONCRETE CYLINDER PIPE CCSP CONCRETE LINED AND COATED STEEL PIP CCCW COUNTER CLOCKWISE CDF CONTROLLED DENSITY FILL CEM CEMENT CHV CHECK VALVE CI CAST IRON CIP CAST IN PLACE, CAST IRON PIPE CIR CIRCLE CJ CONSTRUCTION JOINT CLE CLEAR, CLEARANCE CMP CORRUGATED METAL PIPE CMU CONCRETE MASONRY UNIT COD COUNTY, CLEANOUT COMM COMMUNICATIONS CONC CONCRETE COND CONCRETE COND CONSTRUCTION CONST CONSTRUCTION CONST CONSTRUCTION CONST CONSTRUCTION CONST CONSTRUCTION CONST CONSTRUCT, CONSTRUCTION CONST CONSTRUCT, CONSTRUCTION CONTROL CONTRACTOR CORRETE CORRESCONT CONTRACTOR CONTROL CON	HDPE	HIGH DENSITY POLYETHYLENE
CCSP CONCRETE LINED AND COATED STEEL PIF CCW COUNTER CLOCKWISE CDF CONTROLLED DENSITY FILL CEM CEMENT CHV CHECK VALVE CI CAST IRON CIP CAST IN PLACE, CAST IRON PIPE CIR CIRCLE CJ CONSTRUCTION JOINT CLR CLEAR, CLEARANCE CMP CORRUGATED METAL PIPE CMU CONCRETE MASONRY UNIT CND CONDUIT CO COUNTY, CLEANOUT COMMUNICATIONS CONC CONCRETE COND CONSTRUCTION CONST CONSTRUCTION CONST CONSTRUCT, CONSTRUCTION CONST CONSTRUCT, CONSTRUCTION CONST CONTRACTOR CORRESC, CORRUGATION CONCRETE COOR CORRUGATED, CORRUGATION CONTRACTOR CORRUGATED, CORRUGATION CONTRACTOR CORRUGATED, CORRUGATION CONCRETE CONTROCTOR CORRUGATED, CORRUGATION CONTROCTOR CORRUGATED, CORRUGATION CONTROCTOR CORRUGATED, CORRUGATION CONCRETE CONTROCTOR CORRUGATED, CORRUGATION CONTROCTOR CONTROCTOR CORRUGATED, CORRUGATION CONTROCTOR	HORIZ	HORIZONTAL
CCW COUNTER CLOCKWISE CDF CONTROLLED DENSITY FILL CEM CEMENT CHY CHECK VALVE CI CAST IRON CIP CAST IN PLACE, CAST IRON PIPE CIR CIRCLE CJ CONSTRUCTION JOINT CLE CLEAR, CLEARANCE CMP CORRUGATED METAL PIPE CMU CONCRETE MASONRY UNIT CND CONDUIT COO COUNTY, CLEANOUT COMMUNICATIONS CONC CONCRETE COND CONDITION CONNECT, CONNECTION CONNECT, CONSTRUCTION CONSTRUCT, CONSTRUCTION CONTRACTOR CONT CONTRACTOR CORRESCAND CORRUGATION CONTRACTOR CONTROLLED CONTRO	HT	HEIGHT
CCW COUNTER CLOCKWISE CDF CONTROLLED DENSITY FILL CEM CEMENT CHY CHECK VALVE CI CAST IRON CIP CAST IN PLACE, CAST IRON PIPE CIR CIRCLE CJ CONSTRUCTION JOINT CLE CLEAR, CLEARANCE CMP CORRUGATED METAL PIPE CMU CONCRETE MASONRY UNIT CND CONDUIT COO COUNTY, CLEANOUT COMMUNICATIONS CONC CONCRETE COND CONDITION CONNECT, CONNECTION CONNECT, CONSTRUCTION CONSTRUCT, CONSTRUCTION CONTRACTOR CONT CONTRACTOR CORRESCAND CORRUGATION CONTRACTOR CONTROLLED CONTRO	E HWY	HIGHWAY
CODF CONTROLLED DENSITY FILL CEM CEMENT CHY CHECK VALVE CI CAST IRON CIP CAST IN PLACE, CAST IRON PIPE CIR CIRCLE CJ CONSTRUCTION JOINT CLR CLEAR, CLEARANCE CMP CORRUGATED METAL PIPE CMU CONCRETE MASONRY UNIT CDD COUNTY, CLEANOUT COMM COMMUNICATIONS CONC CONCRETE COND CONDITION CONN CONNECT, CONSTRUCTION CONST CONSTRUCT, CONSTRUCTION CONST CONSTRUCT, CONSTRUCTION CONTROL CONTRUCT, CONTINUOUS CONTRUCT, CONTINUOUS CONTRUCT, CONTINUOUS CONTRUCT, CONTRUCTION CONTRUCTOR CORRUGATED, CORRUGATION COTTOR CONTRUCTOR CORRUGATED, CORRUGATION CONSTC CUSHED SURFACING BASE COURSE CSTC CRUSHED SURFACING TOP COURSE CSTC CRUSHED TOP C	IE	INVERT ELEVATION
CEM CEMENT CHY CHECK VALVE CI CHECK VALVE CI CAST IRON CIP CAST IN PLACE, CAST IRON PIPE CIR CIRCLE CJ CONSTRUCTION JOINT CLR CLEAR, CLEARANCE CMP CORRUGATED METAL PIPE CMU CONCRETE MASONRY UNIT CND CONDUIT CO COUNTY, CLEANOUT COMM COMMUNICATIONS CONC CONCRETE COND CONDITION CONST CONSTRUCTION CONST CONSTRUCT, CONSTRUCTION CONST CONSTRUCT, CONSTRUCTION CONTROLORY CONTROLORY CORRETE COOR CORRUGATED, CORRUGATION CONTROLORY CONT	IN	INCH
CHV CHECK VALVE CI CAST IRON CIP CAST IN PLACE, CAST IRON PIPE CIR CIRCLE CJ CONSTRUCTION JOINT CLEAR, CLEARANCE CMP CORRUGATED METAL PIPE CMU CONCRETE MASONRY UNIT CND CONDUIT CO COUNTY, CLEANOUT COMMUNICATIONS CONC CONCRETE COND CONDITION CONST CONSTRUCT; CONSTRUCTION CONST CONSTRUCT, CONSTRUCTION CONST CONSTRUCT, CONSTRUCTION CONTE CONTRACTOR CORRESCONT CORRUGATION COTTO CLEAN OUT TO GROUND CPLG COUPLING CSBC CRUSHED SURFACING BASE COURSE CSTC CRUSHED SURFACING TOP COURSE CSTC CRUSHED TOR COURSE CSTC CRUSHED TOR COURSE CSTC CRUSHED TOR CSTC TOR	INCL	INCLUDE, INCLUDING
CAST IRON CIP CAST IN PLACE, CAST IRON PIPE CIR CIRCLE CIR CIRCLE CONCRUGATED METAL PIPE COND CONDUIT CONDUIT CONTY CLEANOUT COMMUNICATIONS CONC CONCRETE COND CONDITION CONSTRUCT, CONSTRUCTION CONTY CONTRACTOR CORT CORTRACTOR CORRUGATED, CORRUGATION CONTRACTOR CORRUGATED, CORRUGATION CONTRACTOR CORRUGATED, CORRUGATION CORPUES CORRUGATED, CORRUGATION CORRUGATED CORRUGATED CORRUGATED CORRUGATED CORRUGATED CORRUGATED CORRUGATION CORRUGATED		
CIP CAST IN PLACE, CAST IRON PIPE CIR CIRCLE CJ CONSTRUCTION JOINT CLR CLEAR, CLEARANCE CMP CORRUGATED METAL PIPE CMU CONCRETE MASONRY UNIT CDD COUNTY, CLEANOUT COMM COMMUNICATIONS CONC CONCRETE COND CONDITION CONN CONNECT, CONSTRUCTION CONST CONSTRUCT, CONSTRUCTION CONT CONTINUE, CONTINUOUS CONT CONTINUE, CONTINUOUS CONT CONTRUCT, CONTRUCTION CONTRUCTOR CORRUGATED, CORRUGATION COTOR CORRUGATED, CORRUGATION COTOR COUPLING CSBC CRUSHED SURFACING BASE COURSE CSTC CRUSHED SURFACING TOP COURSE CSTC CULVERT CSV CULVERT CSV CULVERT CSV CUBIC YARD DEPTH, DENSITY, DRAIN, DRAINAGE DEGGE DEMO DEMOLITION	INFO	INFORMATION
CIR CIRCLE CJ CONSTRUCTION JOINT CLR CLEAR, CLEARANCE CDMP CORRUGATED METAL PIPE CDMU CONCRETE MASONRY UNIT CDM CONDUIT CO COUNTY, CLEANOUT COMM COMMUNICATIONS CONC CONCRETE COND CONDITION CONST CONSTRUCT, CONSTRUCTION CONST CONSTRUCT, CONSTRUCTION CONST CONSTRUCT, CONSTRUCTION CONTE CONTRACTOR CONTR CONTRACTOR CORRUGATED, CORRUGATION COTOR COTOR CORRUGATED, CORRUGATION COTOR COTOR CORRUGATED, CORRUGATION COTOR CORRUGATED, CORRUGATION COTOR CORRUGATED, CORRUGATION COTOR CORSIDER CORRUGATED, CORRUGATION COTOR CORSIDER CONTROL CON	INSTL	INSTALL, INSTALLATION
CJ CONSTRUCTION JOINT CLR CLEAR, CLEARANCE CMP CORRUGATED METAL PIPE CMU CONCRETE MASONRY UNIT CDD CONDUIT CCO COUNTY, CLEANOUT COMM COMMUNICATIONS CONC CONCRETE COND CONDITION CONNECT, CONSTRUCTION CONSTRUCT, CONSTRUCTION CONT CONTRACTOR CORR CORRUGATED, CORRUGATION COTTA CONTRACTOR C	INT	INTERIOR, INTERSECTION
CLR CLEAR, CLEARANCE CMP CORRUGATED METAL PIPE CMU CONCRETE MASONRY UNIT COD COUNTY, CLEANOUT COMM COMMUNICATIONS CONC CONCRETE COND CONDITION CONN CONNECT, CONNECTION CONST CONSTRUCT, CONSTRUCTION CONST CONSTRUCT, CONSTRUCTION CONT CONTINUE, CONTINUOUS CONT CONTINUE, CONTINUOUS CONT CONTRUCTOR CORR CORRUGATED, CORRUGATION COTO CLEAN OUT TO GROUND CDED CUPLING CSBC CRUSHED SURFACING BASE COURSE CSTC CRUSHED SURFACING TOP COURSE CSTC CRUSHED SURFACING TOP COURSE CSTC CRUSHED SURFACING TOP COURSE CSTC CONTROL VALVE CUL CULVERT COV CUBIC YARD DEPTH, DENSITY, DRAIN, DRAINAGE DEGGE DEMO DEMOLITION	INV	INVERT
CMP CORRUGATED METAL PIPE CMU CONCRETE MASONRY UNIT CND CONDUIT CCO COUNTY, CLEANOUT COMM COMMUNICATIONS CONC CONCRETE COND CONDITION CONST CONSTRUCT; CONSTRUCTION CONST CONSTRUCT; CONSTRUCTION CONT CONTINUE, CONTINUOUS CONT CONTINUE, CONTINUOUS CONT CONTRUCT; CONTRUCTION COTOR CONTRUCT; CONTRUCTION CONT CONTRUCT; CONSTRUCTION CONT CONTRUCT; CONSTRUCTION CONT CONTRUCT; CONSTRUCTION CONT CONTRUCT; CONSTRUCTION CONTRUCT; CONSTRUCTION CONTRUCT; CONSTRUCTION CONTRUCT; CONTRUCTION CONTRUCT; CONTRUCTION CONTROL CONTROL SALE CONTROL CONTROL SALE CONTROL VALVE CUT CUBIC YARD DEPTH, DENSITY, DRAIN, DRAINAGE DEGGE DEMO DEMOLITION	LF	LINEAR FEET, LINEAR FOOT
CMP CORRUGATED METAL PIPE CMU CONCRETE MASONRY UNIT CND CONDUIT CCO COUNTY, CLEANOUT COMM COMMUNICATIONS CONC CONCRETE COND CONDITION CONN CONNECT, CONSTRUCTION CONST CONSTRUCT, CONSTRUCTION CONST CONSTRUCT, CONSTRUCTION CONTE CONTINUE, CONTINUOUS CONT CONTINUE, CONTINUOUS CONT CONTRUCT, CONTINUOUS CONTE CONTRACTOR CORRUGATED, CORRUGATION COTE CLEAN OUT TO GROUND CPLG COUPLING CSBC CRUSHED SURFACING BASE COURSE CSTC CRUSHED SURFACING TOP COURSE CSTC CRUSHED SURFACING TOP COURSE CSTC CRUSHED SURFACING TOP COURSE CSTC CONTROL VALVE CULVERT CV CUNTROL VALVE CY CUBIC YARD DEPTH, DENSITY, DRAIN, DRAINAGE DEGGE DEMO DEMOLITION	LOC	LOCATION
COMU CONCRETE MASONRY UNIT COND CONDUIT CO COUNTY, CLEANOUT COMM COMMUNICATIONS CONC CONCRETE COND CONDITION CONNECT, CONNECTION CONST CONSTRUCT, CONSTRUCTION CONST CONSTRUCT, CONSTRUCTION CONT CONTINUE, CONTINUOUS CONT CONTRACTOR CORR CORRUGATED, CORRUGATION COTG CLEAN OUT TO GROUND CPLG COUPLING CSBC CRUSHED SURFACING BASE COURSE CSTC CRUSHED SURFACING TOP COURSE CSTC CONTROL VALVE CY CUBIC YARD DEPTH, DENSITY, DRAIN, DRAINAGE DEGGEE DEMO DEMOLITION	MALL	MALLEABLE
COND CONDUIT CO COUNTY, CLEANOUT COMM COMMUNICATIONS CONC CONCRETE COND CONDITION CONST CONSTRUCT, CONSTRUCTION CONT CONT CONT CONTRACTOR CORR CORR CORR CORR CORR CORR CORR	MH	MANHOLE
COUNTY, CLEANOUT COMM COMMUNICATIONS CONC CONCRETE COND CONDITION CONN CONNECT, CONNECTION CONST CONSTRUCT, CONSTRUCTION CONST CONSTRUCT, CONSTRUCTION CONT CONTINUE, CONTINUOUS CONT CONTRACTOR CORR CORRUGATED, CORRUGATION COTE CLEAN OUT TO GROUND COTE CUPLING CSBC CRUSHED SURFACING BASE COURSE CSTC CRUSHED SURFACING TOP COURSE CSTC CRUSHED SURFACING TOP COURSE CSTC CRUSHED SURFACING TOP COURSE CSTC CONTROL VALVE CY CUBIC YARD DEPTH, DENSITY, DRAIN, DRAINAGE DEGG DEGMO DEMOLITION	MISC	MISCELLANEOUS
COMM COMMUNICATIONS CONC CONCRETE COND CONDETT COND CONDITION CONST CONSTRUCT, CONSTRUCTION CONST CONSTRUCT, CONSTRUCTION CONT CONTINUE, CONTINUOUS CONTR CONTRACTOR CORR CORRUGATED, CORRUGATION COTG CLEAN OUT TO GROUND CPLG COUPLING CSBC CRUSHED SURFACING BASE COURSE CSTC CRUSHED SURFACING TOP COURSE CSTC CONTROL VALVE CY CULVERT CSV CONTROL VALVE CY CUBIC YARD DEPTH, DENSITY, DRAIN, DRAINAGE DEGGE DEMO DEMOLITION	MJ	MECHANICAL JOINT
CONC CONCRETE COND CONDITION CONNECT, CONNECTION CONSTRUCT, CONSTRUCTION CONT CONTROCTOR CONT CONTRACTOR CORR CORR CORR CORR CORR CORR CORR	MON	MONUMENT
COND CONDITION CONNECT, CONNECTION CONST CONSTRUCT, CONSTRUCTION CONST CONSTRUCT, CONSTRUCTION CONT CONTRUE, CONTINUOUS CONTR CONTRACTOR CORR CORRUGATED, CORRUGATION COTG CLEAN OUT TO GROUND CPLG COUPLING CSBC CRUSHED SURFACING BASE COURSE CSTC CRUSHED SURFACING TOP COURSE CSTC CRUSHED SURFACING TOP COURSE CSTC CRUSHED SURFACING TOP COURSE CSTC CONTROL VALVE CV CONTROL VALVE CV CUBIC YARD DEPTH, DENSITY, DRAIN, DRAINAGE DEGG DEMO DEMOLITION		
CONN CONNECT, CONNECTION CONST CONSTRUCT, CONSTRUCTION CONT CONSTRUCT, CONSTRUCTION CONT CONTINUE, CONTINUOUS CONTR CONTRACTOR CORR CORRUGATED, CORRUGATION COTG CLEAN OUT TO GROUND CDLG COUPLING CSBC CRUSHED SURFACING BASE COURSE CSTC CRUSHED SURFACING TOP COURSE CSTC CRUSHED SURFACING TOP COURSE CSTC CRUSHED SURFACING TOP COURSE CSTC CONTROL VALVE CULVERT CV CONTROL VALVE CY CUBIC YARD DEPTH, DENSITY, DRAIN, DRAINAGE DEGG DEMO DEMOLITION	MW	MONITORING WELL
CONST CONSTRUCT, CONSTRUCTION CONTINUE, CONTINUOUS CONTR CONTRACTOR CORRECATED, CORRUGATION COTG CLEAN OUT TO GROUND CPLG COUPLING CSBC CRUSHED SURFACING BASE COURSE CSTC CRUSHED SURFACING TOP COURSE CSTC COULV CULVERT CSV CONTROL VALVE CSV CUBIC YARD DEPTH, DENSITY, DRAIN, DRAINAGE DEGGE DEMO DEMOLITION	N	NORTH, NORTHING
CONT CONTINUE, CONTINUOUS CONTR CONTRACTOR CORR CORRUGATED, CORRUGATION COTG CLEAN OUT TO GROUND CPLG COUPLING CSBC CRUSHED SURFACING BASE COURSE CSTC CRUSHED SURFACING TOP COURSE CTR CENTER CULV CULVERT CV CONTROL VALVE CY CUBIC YARD DEPTH, DENSITY, DRAIN, DRAINAGE DEGMO DEMOLITION	NC	NORMALLY CLOSED
CONTR CONTRACTOR CORR CORRUGATION COTG CLEAN OUT TO GROUND CPLG COUPLING CSBC CRUSHED SURFACING BASE COURSE CSTC CRUSHED SURFACING TOP COURSE CTR CENTER CULV CULVERT CV CONTROL VALVE CY CUBIC YARD DEPTH, DENSITY, DRAIN, DRAINAGE DEGM DEMOLITION	NO	NORMALLY OPEN
CORR CORRUGATED, CORRUGATION COTG CLEAN OUT TO GROUND CPLG COUPLING CSBC CRUSHED SURFACING BASE COURSE CSTC CRUSHED SURFACING TOP COURSE CTR CENTER CULV CULVERT CV CONTROL VALVE CY CUBIC YARD DEPTH, DENSITY, DRAIN, DRAINAGE DEGGE DEMO DEMOLITION	OC	ON CENTER
CORR CORRUGATED, CORRUGATION COTG CLEAN OUT TO GROUND CPLG COUPLING CSBC CRUSHED SURFACING BASE COURSE CSTC CRUSHED SURFACING TOP COURSE CTR CENTER CULV CULVERT CV CONTROL VALVE CY CUBIC YARD DEPTH, DENSITY, DRAIN, DRAINAGE DEGGE DEMO DEMOLITION	OVHD	OVERHEAD
COTG CLEAN OUT TO GROUND CPLG COUPLING CSBC CRUSHED SURFACING BASE COURSE CSTC CRUSHED SURFACING TOP COURSE CTR CENTER CULV CULVERT CV CONTROL VALVE CY CUBIC YARD DEPTH, DENSITY, DRAIN, DRAINAGE DEG DEGREE DEMO DEMOLITION	P	PUMP, POWER
CPLG COUPLING CSBC CRUSHED SURFACING BASE COURSE CSTC CRUSHED SURFACING TOP COURSE CTR CENTER CULV CULVERT CV CONTROL VALVE CY CUBIC YARD DEPTH, DENSITY, DRAIN, DRAINAGE DEGMO DEMOLITION	PC	POINT OF CURVATURE
CSBC CRUSHED SURFACING BASE COURSE CSTC CRUSHED SURFACING TOP COURSE CTR CENTER CULV CULVERT CV CONTROL VALVE CY CUBIC YARD DEPTH, DENSITY, DRAIN, DRAINAGE DEGRE DEMO DEMOLITION	PCC	
CSTC CRUSHED SURFACING TOP COURSE CITE CENTER CULV CULVERT CV CONTROL VALVE CY CUBIC YARD DEPTH, DENSITY, DRAIN, DRAINAGE DEG DEGREE DEMO DEMOLITION		PORTLAND CEMENT CONCRETE
CTR CENTER CULV CULVERT CV CONTROL VALVE CY CUBIC YARD DEPTH, DENSITY, DRAIN, DRAINAGE DEG DEGREE DEMO DEMOLITION	PERF	PERFORATE, PERFORATED
CULV CULVERT CV CONTROL VALVE CY CUBIC YARD DEPTH, DENSITY, DRAIN, DRAINAGE DEG DEGREE DEMO DEMOLITION	PI	POINT OF INTERSECTION, PRESSURE INDICATOR
CV CONTROL VALVE CY CUBIC YARD DEPTH, DENSITY, DRAIN, DRAINAGE DEG DEGREE DEMO DEMOLITION	POC	POINT ON CURVE
CY CUBIC YARD DEPTH, DENSITY, DRAIN, DRAINAGE DEG DEGREE DEMO DEMOLITION	PP	POWER POLE
CY CUBIC YARD DEPTH, DENSITY, DRAIN, DRAINAGE DEG DEGREE DEMO DEMOLITION	PT	POINT OF TANGENCY, POINT
DEPTH, DENSITY, DRAIN, DRAINAGE DEG DEGREE DEMO DEMOLITION	PVI	POINT OF VERTICAL INTERSECTION
DEG DEGREE DEMO DEMOLITION	RAD	RADIUS
DEMO DEMOLITION	RC	REINFORCED CONCRETE
	RCP	
DETAIL DETAIL		REINFORCED CONCRETE PIPE
	RD	ROAD, ROOF DRAIN
DI DUCTILE IRON	RED	REDUCER
DIA DIAMETER	REQD	REQUIRED
DIM DIMENSION	ROW	RIGHT OF WAY
DIP DUCTILE IRON PIPE	RR	RAILROAD

ABBREVIATIONS

DETAIL AND SECTION DESIGNATION

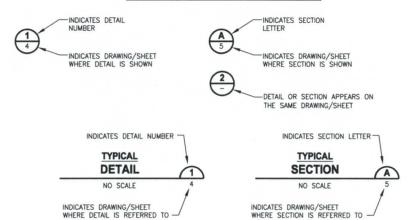











SILVER VILLAGE PAVEMENT PRESERVATION AND PEDESTRIAN IMPORVEMENTS THE TULALIP TRIBES


TULALIP, WA


GENERAL NOTES, LEGEND AND ABBREVIATIONS


Know what's below. Call before you dig.

> SHEET NO. 3 OF 32

> > G3

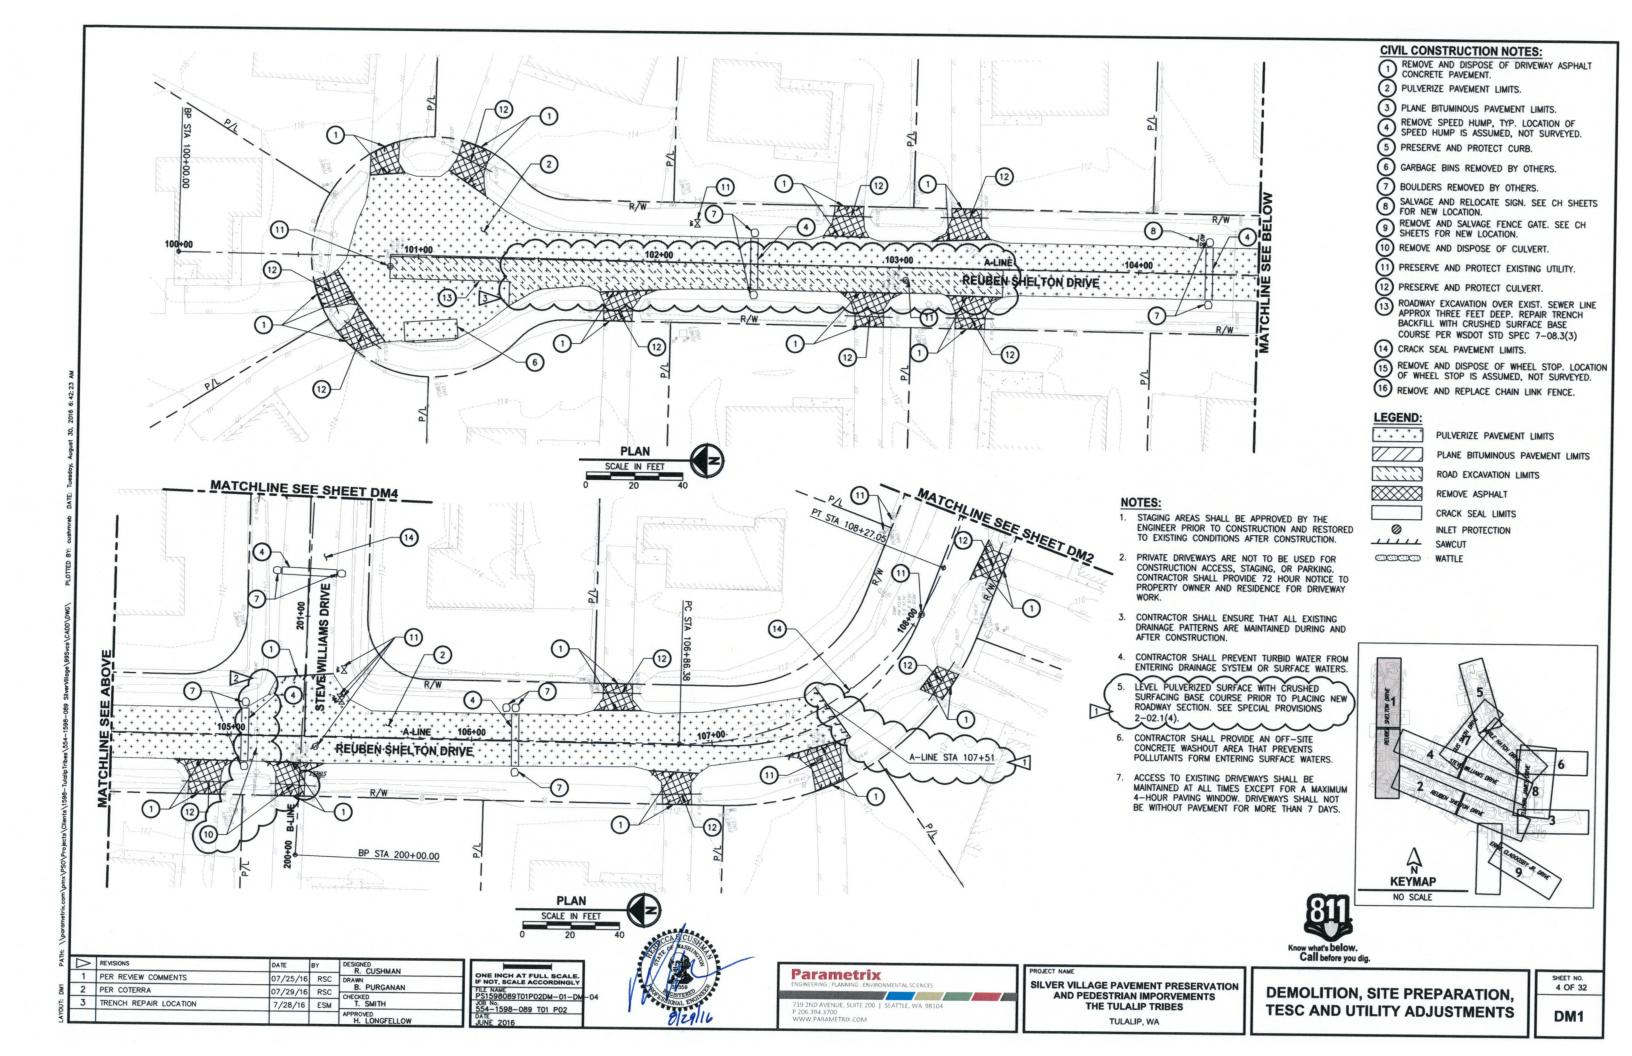

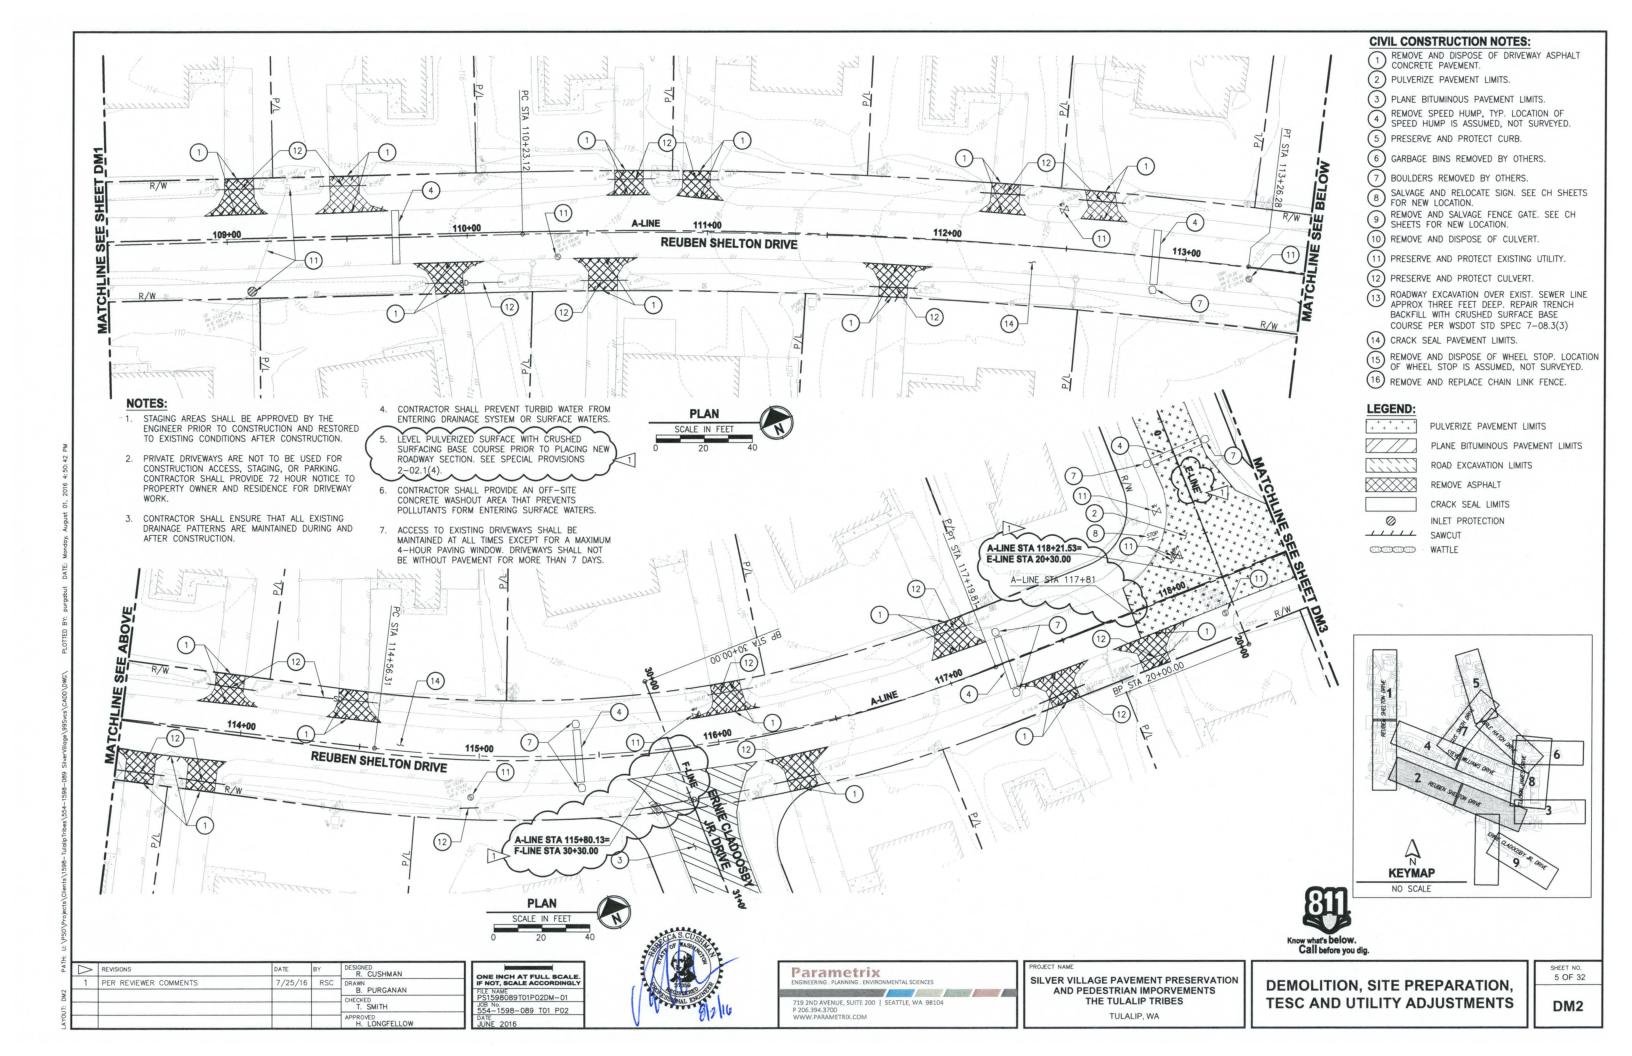

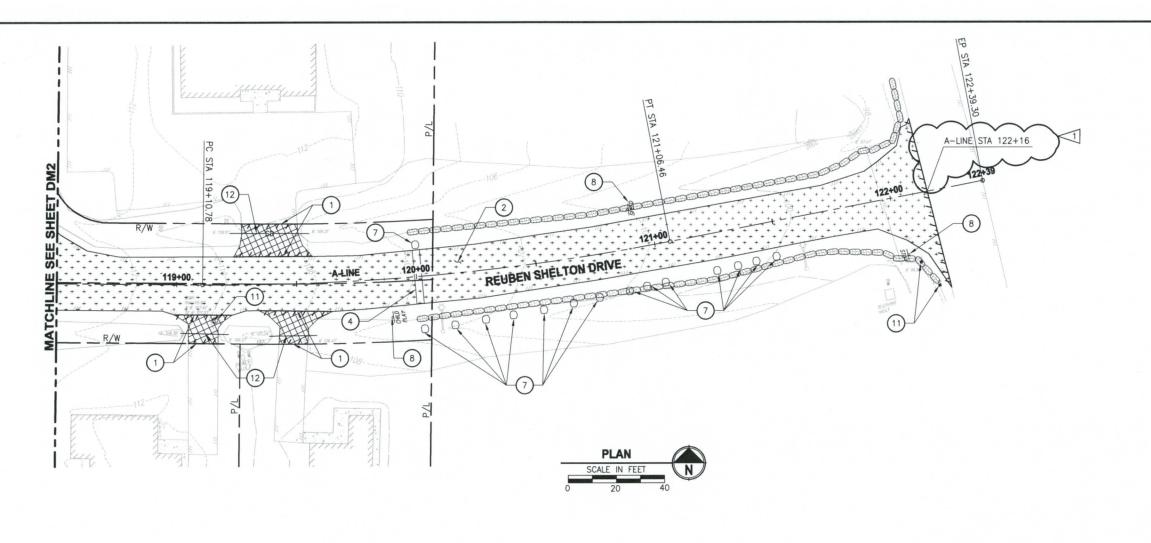

- PRIVATE DRIVEWAYS ARE NOT TO BE USED FOR
- CONTRACTOR SHALL PREVENT TURBID WATER FROM
- LEVEL PULVERIZED SURFACE WITH CRUSHED SURFACING BASE COURSE PRIOR TO PLACING NEW ROADWAY SECTION. SEE SPECIAL PROVISIONS 2-02.1(4).
 - CONTRACTOR SHALL PROVIDE AN OFF-SITE CONCRETE WASHOUT AREA THAT PREVENTS
 - ACCESS TO EXISTING DRIVEWAYS SHALL BE MAINTAINED AT ALL TIMES EXCEPT FOR A MAXIMUM 4-HOUR PAVING WINDOW. DRIVEWAYS SHALL NOT

CIVIL CONSTRUCTION NOTES:

- REMOVE AND DISPOSE OF DRIVEWAY ASPHALT CONCRETE PAVEMENT.
- 2 PULVERIZE PAVEMENT LIMITS.
- (3) PLANE BITUMINOUS PAVEMENT LIMITS.
- REMOVE SPEED HUMP, TYP. LOCATION OF SPEED HUMP IS ASSUMED, NOT SURVEYED.
- (5) PRESERVE AND PROTECT CURB.
- (6) GARBAGE BINS REMOVED BY OTHERS.
- BOULDERS REMOVED BY OTHERS.
- 8 SALVAGE AND RELOCATION. SALVAGE AND RELOCATE SIGN. SEE CH SHEETS
- 9 REMOVE AND SALVAGE FENCE GATE. SEE CH SHEETS FOR NEW LOCATION.
- (10) REMOVE AND DISPOSE OF CULVERT.
- (11) PRESERVE AND PROTECT EXISTING UTILITY.
- (12) PRESERVE AND PROTECT CULVERT.
- ROADWAY EXCAVATION OVER EXIST. SEWER LINE APPROX THREE FEET DEEP. REPAIR TRENCH BACKFILL WITH CRUSHED SURFACE BASE COURSE PER WSDOT STD SPEC 7-08.3(3)
- (14) CRACK SEAL PAVEMENT LIMITS.
- REMOVE AND DISPOSE OF WHEEL STOP. LOCATION OF WHEEL STOP IS ASSUMED, NOT SURVEYED.
- (16) REMOVE AND REPLACE CHAIN LINK FENCE.

LEGEND:

PULVERIZE PAVEMENT LIMITS PLANE BITUMINOUS PAVEMENT LIMITS

ROAD EXCAVATION LIMITS

REMOVE ASPHALT


CRACK SEAL LIMITS

0 INLET PROTECTION 1111

SAWCUT WATTLE

NOTES:

- STAGING AREAS SHALL BE APPROVED BY THE ENGINEER PRIOR TO CONSTRUCTION AND RESTORED TO EXISTING CONDITIONS AFTER CONSTRUCTION.
- CONSTRUCTION ACCESS, STAGING, OR PARKING.
 CONTRACTOR SHALL PROVIDE 72 HOUR NOTICE TO PROPERTY OWNER AND RESIDENCE FOR DRIVEWAY
- 3. CONTRACTOR SHALL ENSURE THAT ALL EXISTING DRAINAGE PATTERNS ARE MAINTAINED DURING AND AFTER CONSTRUCTION.
- ENTERING DRAINAGE SYSTEM OR SURFACE WATERS.
- POLLUTANTS FORM ENTERING SURFACE WATERS.
- BE WITHOUT PAVEMENT FOR MORE THAN 7 DAYS.

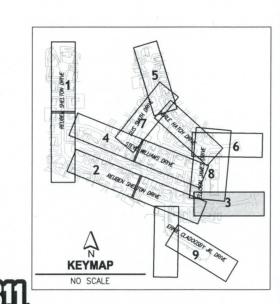

\triangleright	REVISIONS	DATE	BY	DESIGNED R. CUSHMAN
1	PER REVIEW COMMENTS	7/25/16	RSC	DRAWN B. PURGANAN
				CHECKED T. SMITH
				APPROVED NO.

ONE INCH AT FULL SCALE F NOT, SCALE ACCORDINGL 1598089T01P02DM-01 554-1598-089 T01 P02



Parametrix engineering . PLANNING . ERVIRONMENTAL SCIENCES	PROJE SIL\
719 2ND AVENUE, SUITE 200 SEATTLE, WA 98104 P 206.394,3700 WWW.PARAMETRIX.COM	

VER VILLAGE PAVEMENT PRESERVATION AND PEDESTRIAN IMPORVEMENTS THE TULALIP TRIBES


TULALIP, WA


DEMOLITION, SITE PREPARATION. TESC AND UTILITY ADJUSTMENTS


Know what's below.
Call before you dig.

6 OF 32

DM₃

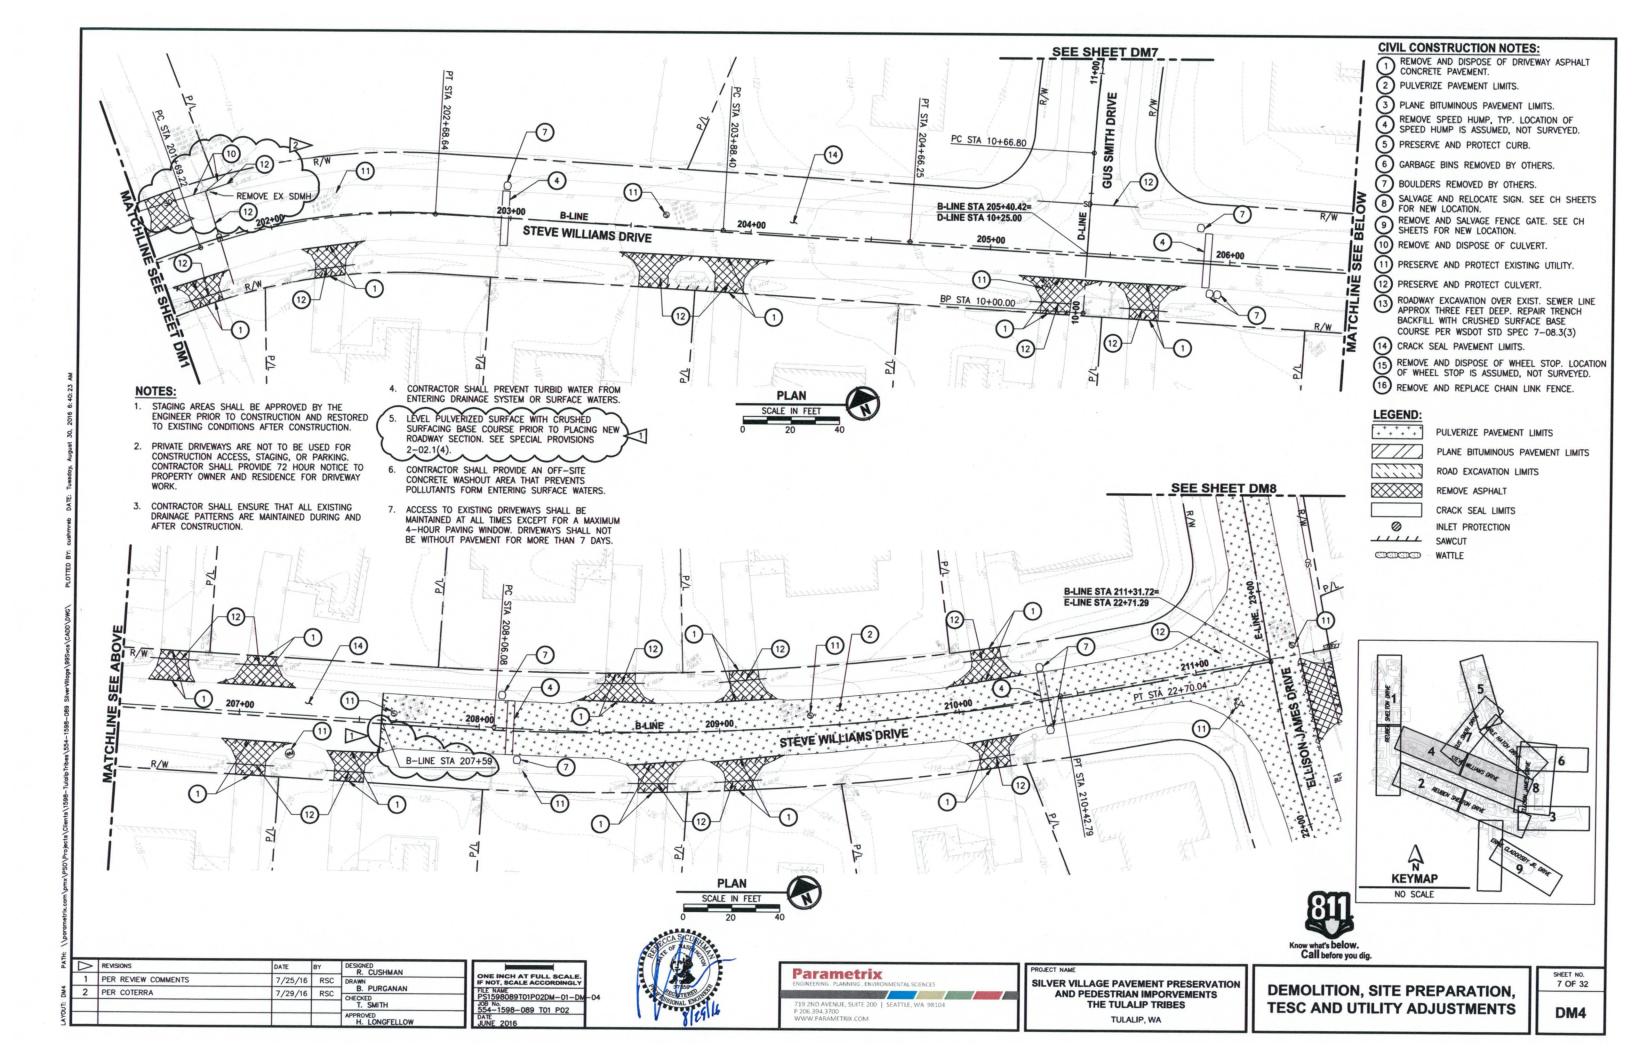

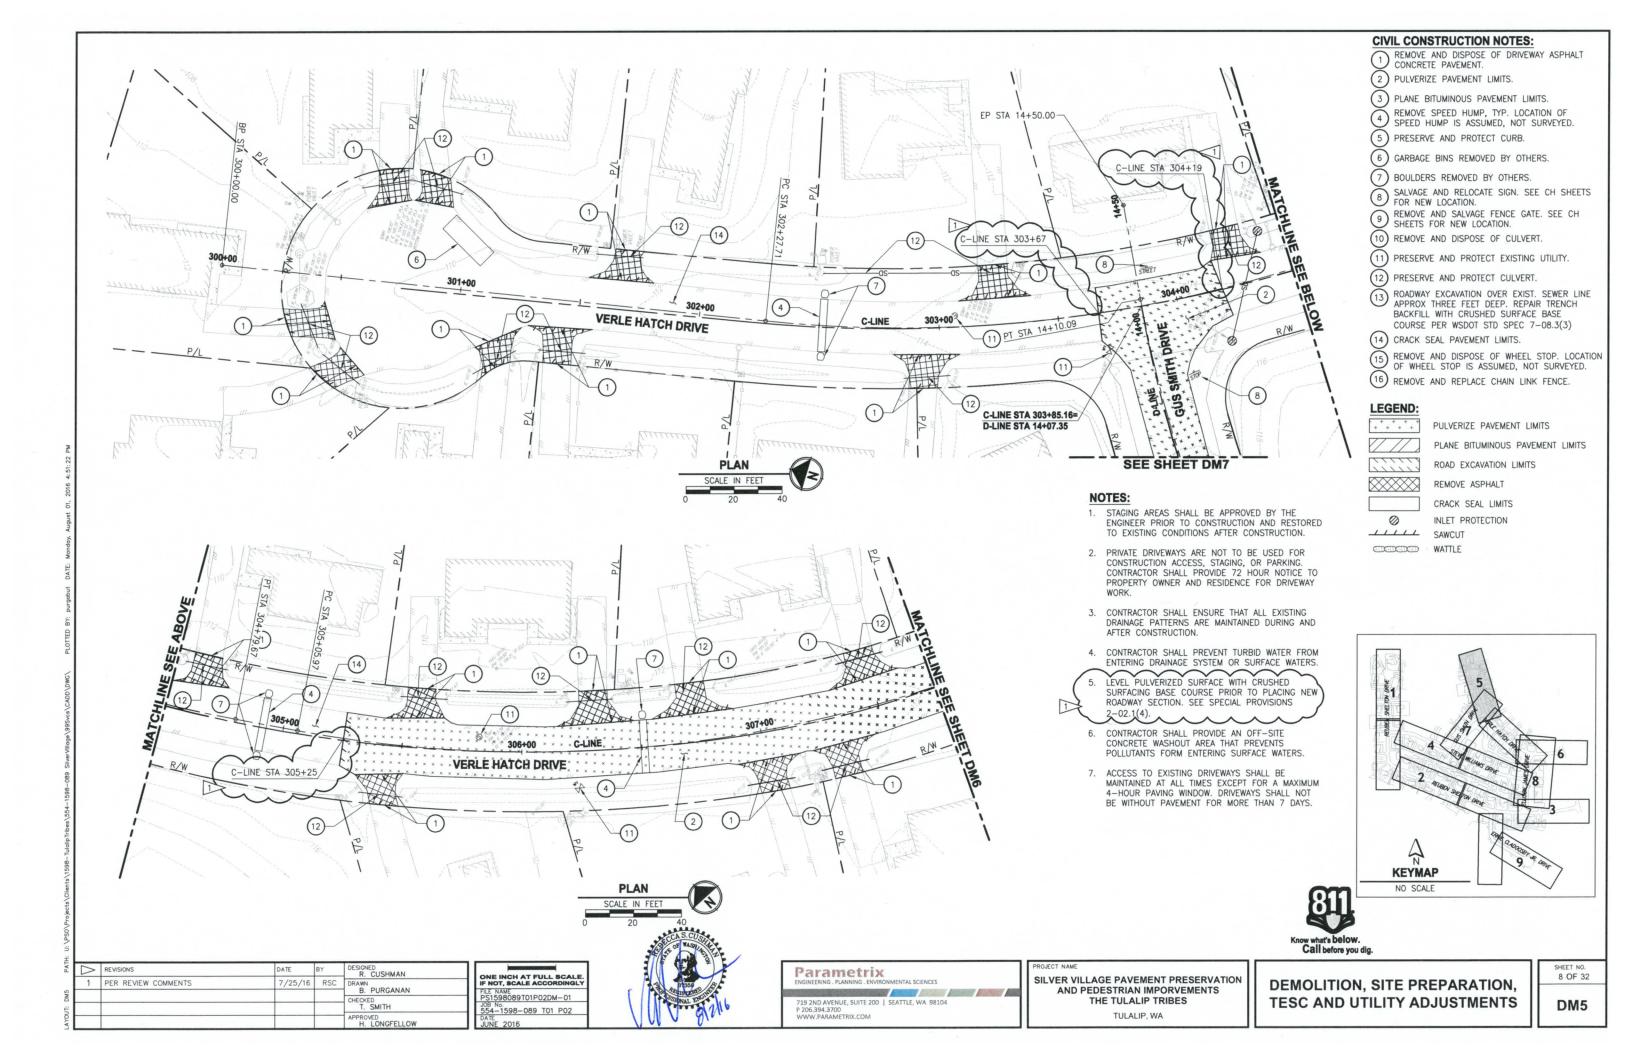

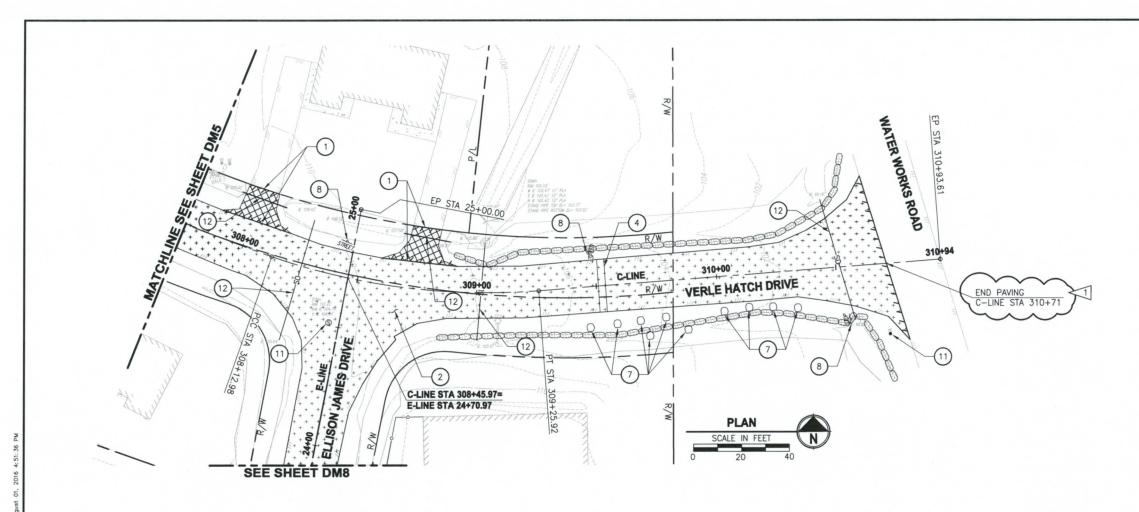

NOTES:

- STAGING AREAS SHALL BE APPROVED BY THE ENGINEER PRIOR TO CONSTRUCTION AND RESTORED TO EXISTING CONDITIONS AFTER CONSTRUCTION.
- 2. PRIVATE DRIVEWAYS ARE NOT TO BE USED FOR CONSTRUCTION ACCESS, STAGING, OR PARKING. CONTRACTOR SHALL PROVIDE 72 HOUR NOTICE TO PROPERTY OWNER AND RESIDENCE FOR DRIVEWAY
- 3. CONTRACTOR SHALL ENSURE THAT ALL EXISTING DRAINAGE PATTERNS ARE MAINTAINED DURING AND AFTER CONSTRUCTION.
- 4. CONTRACTOR SHALL PREVENT TURBID WATER FROM ENTERING DRAINAGE SYSTEM OR SURFACE WATERS.
- LEVEL PULVERIZED SURFACE WITH CRUSHED SURFACING BASE COURSE PRIOR TO PLACING NEW ROADWAY SECTION. SEE SPECIAL PROVISIONS
 - CONTRACTOR SHALL PROVIDE AN OFF-SITE CONCRETE WASHOUT AREA THAT PREVENTS POLLUTANTS FORM ENTERING SURFACE WATERS.
- 7. ACCESS TO EXISTING DRIVEWAYS SHALL BE MAINTAINED AT ALL TIMES EXCEPT FOR A MAXIMUM 4-HOUR PAVING WINDOW, DRIVEWAYS SHALL NOT BE WITHOUT PAVEMENT FOR MORE THAN 7 DAYS.

CIVIL CONSTRUCTION NOTES:

- REMOVE AND DISPOSE OF DRIVEWAY ASPHALT CONCRETE PAVEMENT.
- 2) PULVERIZE PAVEMENT LIMITS.
- PLANE BITUMINOUS PAVEMENT LIMITS.
- REMOVE SPEED HUMP, TYP. LOCATION OF SPEED HUMP IS ASSUMED, NOT SURVEYED.
- (5) PRESERVE AND PROTECT CURB.
- (6) GARBAGE BINS REMOVED BY OTHERS.
- 7 BOULDERS REMOVED BY OTHERS.
- SALVAGE AND RELOCATE SIGN. SEE CH SHEETS FOR NEW LOCATION.
- REMOVE AND SALVAGE FENCE GATE. SEE CH SHEETS FOR NEW LOCATION.
- (10) REMOVE AND DISPOSE OF CULVERT.
- (11) PRESERVE AND PROTECT EXISTING UTILITY.
- (12) PRESERVE AND PROTECT CULVERT.
- ROADWAY EXCAVATION OVER EXIST. SEWER LINE APPROX THREE FEET DEEP. REPAIR TRENCH BACKFILL WITH CRUSHED SURFACE BASE COURSE PER WSDOT STD SPEC 7-08.3(3)
- (14) CRACK SEAL PAVEMENT LIMITS.
- REMOVE AND DISPOSE OF WHEEL STOP. LOCATION OF WHEEL STOP IS ASSUMED, NOT SURVEYED.
- 16) REMOVE AND REPLACE CHAIN LINK FENCE.

LEGEND:

PLANE BITUMINOUS PAVEMENT LIMITS

PULVERIZE PAVEMENT LIMITS

ROAD EXCAVATION LIMITS

REMOVE ASPHALT

0

CRACK SEAL LIMITS INLET PROTECTION

1111

WATTLE

KEYMAP NO SCALE



REVISIONS R. CUSHMAN 1 PER REVIEW COMMENTS 7/25/16 B. PURGANAN T. SMITH

ONE INCH AT FULL SCALE 98089T01P02DM-01 54-1598-089 T01 P02




Parametrix ENGINEERING . PLANNING . ENVIRONMENTAL SCIENCES	Pf S
719 2ND AVENUE, SUITE 200 SEATTLE, WA 98104 P 206.394.3700 WWW.PARAMETRIX.COM	

SILVER VILLAGE PAVEMENT PRESERVATION AND PEDESTRIAN IMPORVEMENTS THE TULALIP TRIBES

TULALIP, WA

DEMOLITION, SITE PREPARATION, TESC AND UTILITY ADJUSTMENTS 9 OF 32

DM₆

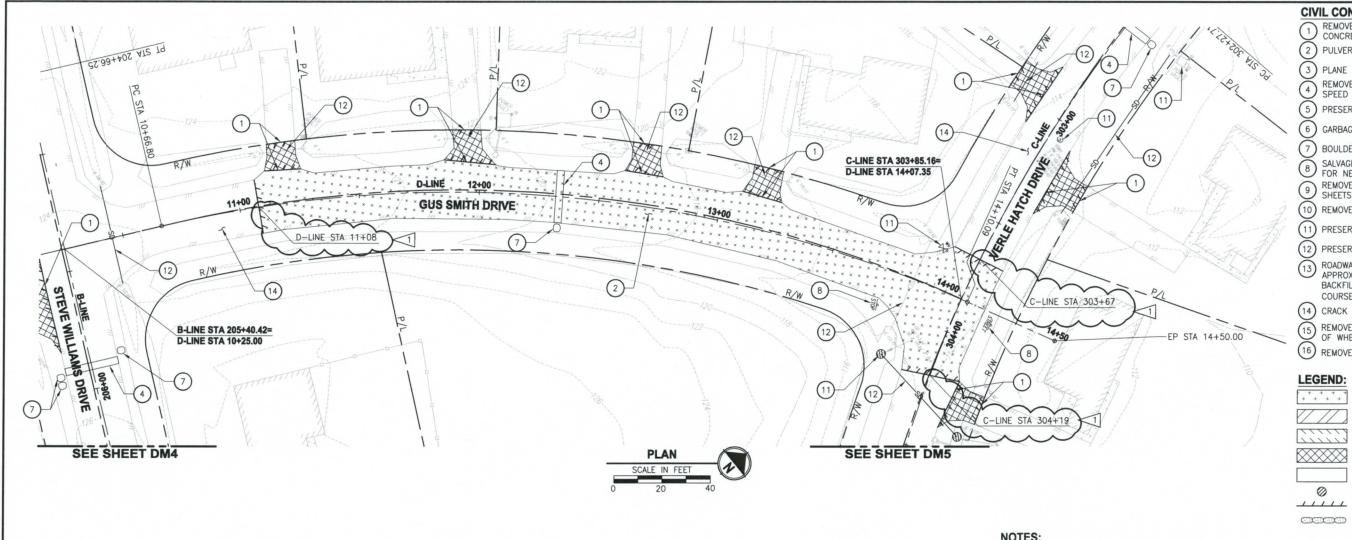

NOTES:

- 1. STAGING AREAS SHALL BE APPROVED BY THE ENGINEER PRIOR TO CONSTRUCTION AND RESTORED TO EXISTING CONDITIONS AFTER CONSTRUCTION.
- PRIVATE DRIVEWAYS ARE NOT TO BE USED FOR CONSTRUCTION ACCESS, STAGING, OR PARKING. CONTRACTOR SHALL PROVIDE 72 HOUR NOTICE TO PROPERTY OWNER AND RESIDENCE FOR DRIVEWAY WORK
- 3. CONTRACTOR SHALL ENSURE THAT ALL EXISTING DRAINAGE PATTERNS ARE MAINTAINED DURING AND AFTER CONSTRUCTION.
- CONTRACTOR SHALL PREVENT TURBID WATER FROM ENTERING DRAINAGE SYSTEM OR SURFACE WATERS.
- LEVEL PULVERIZED SURFACE WITH CRUSHED SURFACING BASE COURSE PRIOR TO PLACING NEW ROADWAY SECTION. SEE SPECIAL PROVISIONS
- CONTRACTOR SHALL PROVIDE AN OFF-SITE CONCRETE WASHOUT AREA THAT PREVENTS POLLUTANTS FORM ENTERING SURFACE WATERS
- ACCESS TO EXISTING DRIVEWAYS SHALL BE MAINTAINED AT ALL TIMES EXCEPT FOR A MAXIMUM 4-HOUR PAVING WINDOW. DRIVEWAYS SHALL NOT BE WITHOUT PAVEMENT FOR MORE THAN 7 DAYS.

CIVIL CONSTRUCTION NOTES: REMOVE AND DISPOSE OF DRIVEWAY ASPHALT CONCRETE PAVEMENT.

2 PULVERIZE PAVEMENT LIMITS.

PLANE BITUMINOUS PAVEMENT LIMITS. REMOVE SPEED HUMP, TYP. LOCATION OF SPEED HUMP IS ASSUMED, NOT SURVEYED.

5 PRESERVE AND PROTECT CURB.

(6) GARBAGE BINS REMOVED BY OTHERS.

(7) BOULDERS REMOVED BY OTHERS.

SALVAGE AND RELOCATE SIGN. SEE CH SHEETS FOR NEW LOCATION.

REMOVE AND SALVAGE FENCE GATE. SEE CH SHEETS FOR NEW LOCATION.

(10) REMOVE AND DISPOSE OF CULVERT.

(11) PRESERVE AND PROTECT EXISTING UTILITY.

(12) PRESERVE AND PROTECT CULVERT.

ROADWAY EXCAVATION OVER EXIST. SEWER LINE APPROX THREE FEET DEEP. REPAIR TRENCH BACKFILL WITH CRUSHED SURFACE BASE COURSE PER WSDOT STD SPEC 7-08.3(3)

(14) CRACK SEAL PAVEMENT LIMITS.

(15) REMOVE AND DISPOSE OF WHEEL STOP. LOCATION OF WHEEL STOP IS ASSUMED, NOT SURVEYED.

(16) REMOVE AND REPLACE CHAIN LINK FENCE.

LEGEND:

PLANE BITUMINOUS PAVEMENT LIMITS

PULVERIZE PAVEMENT LIMITS

ROAD EXCAVATION LIMITS

REMOVE ASPHALT CRACK SEAL LIMITS

0

INLET PROTECTION

1111

SAWCUT



REVISIONS DESIGNED R. CUSHMAN 1 PER REVIEW COMMENTS 7/25/16 RSC B. PURGANAN T. SMITH PPROVED
H. LONGFELLOW

ONE INCH AT FULL SCALE FILE NAME PS1598089T01P02DM-01 554-1598-089 T01 P02





PROJECT NAME

SILVER VILLAGE PAVEMENT PRESERVATION AND PEDESTRIAN IMPORVEMENTS THE TULALIP TRIBES


TULALIP, WA


DEMOLITION, SITE PREPARATION, TESC AND UTILITY ADJUSTMENTS


KEYMAP NO SCALE

10 OF 32

DM7

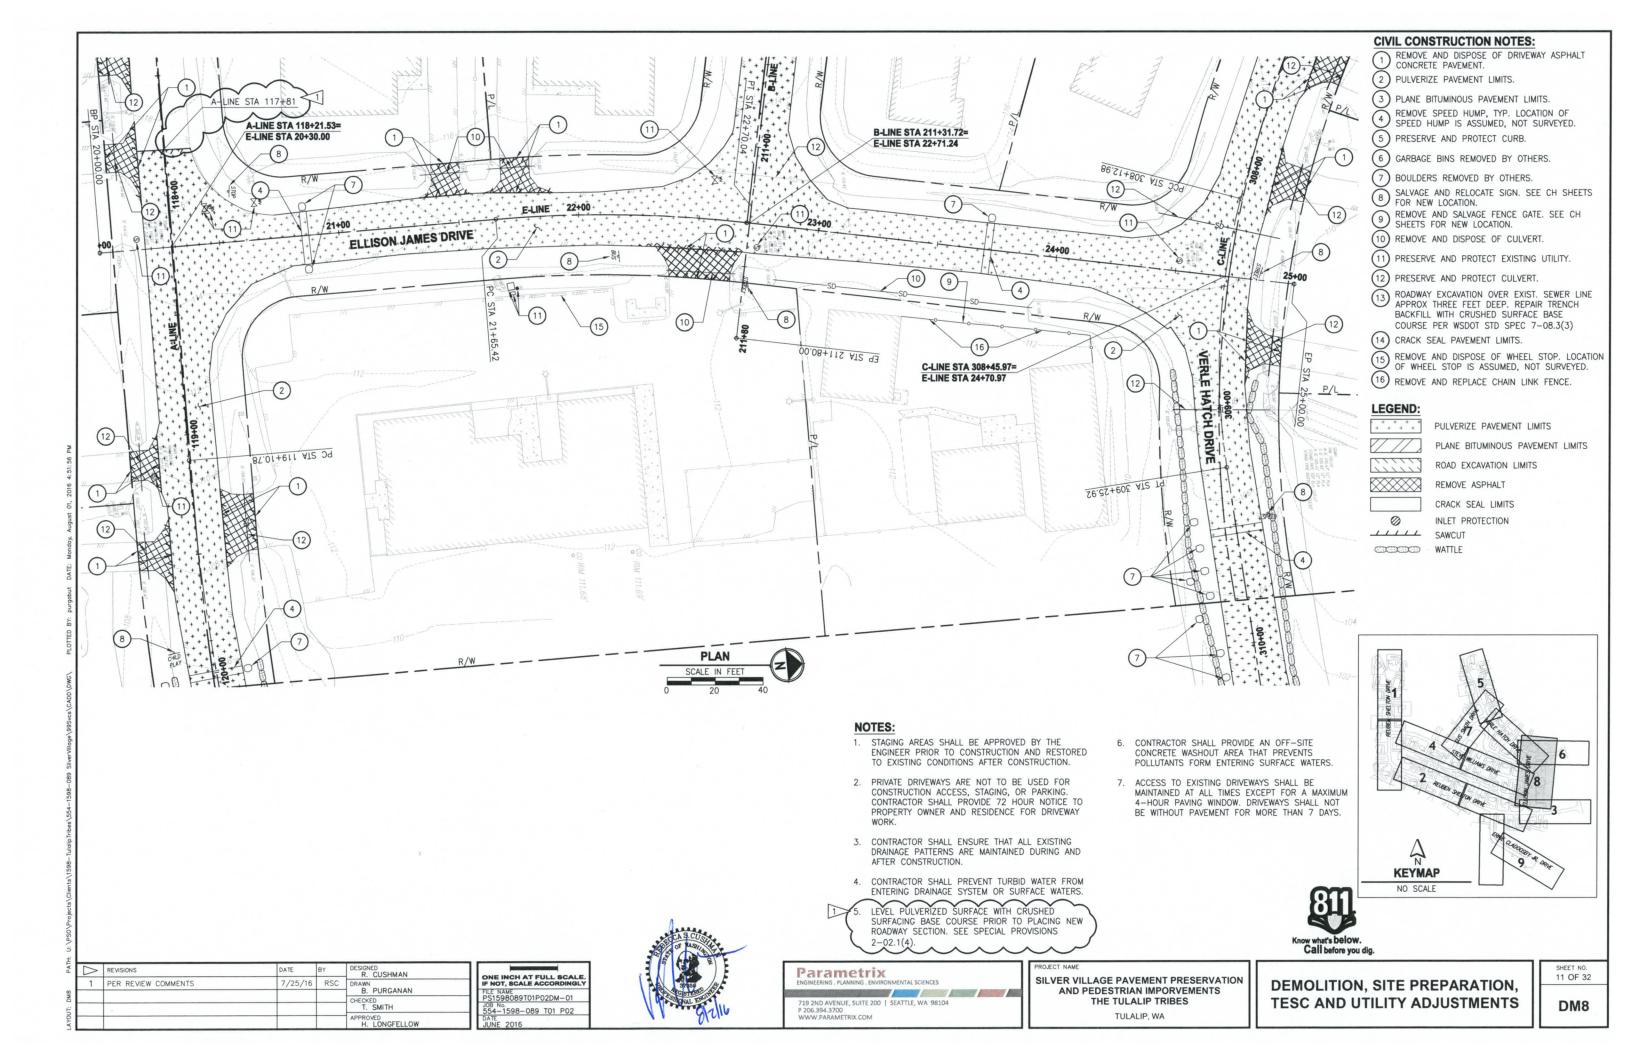

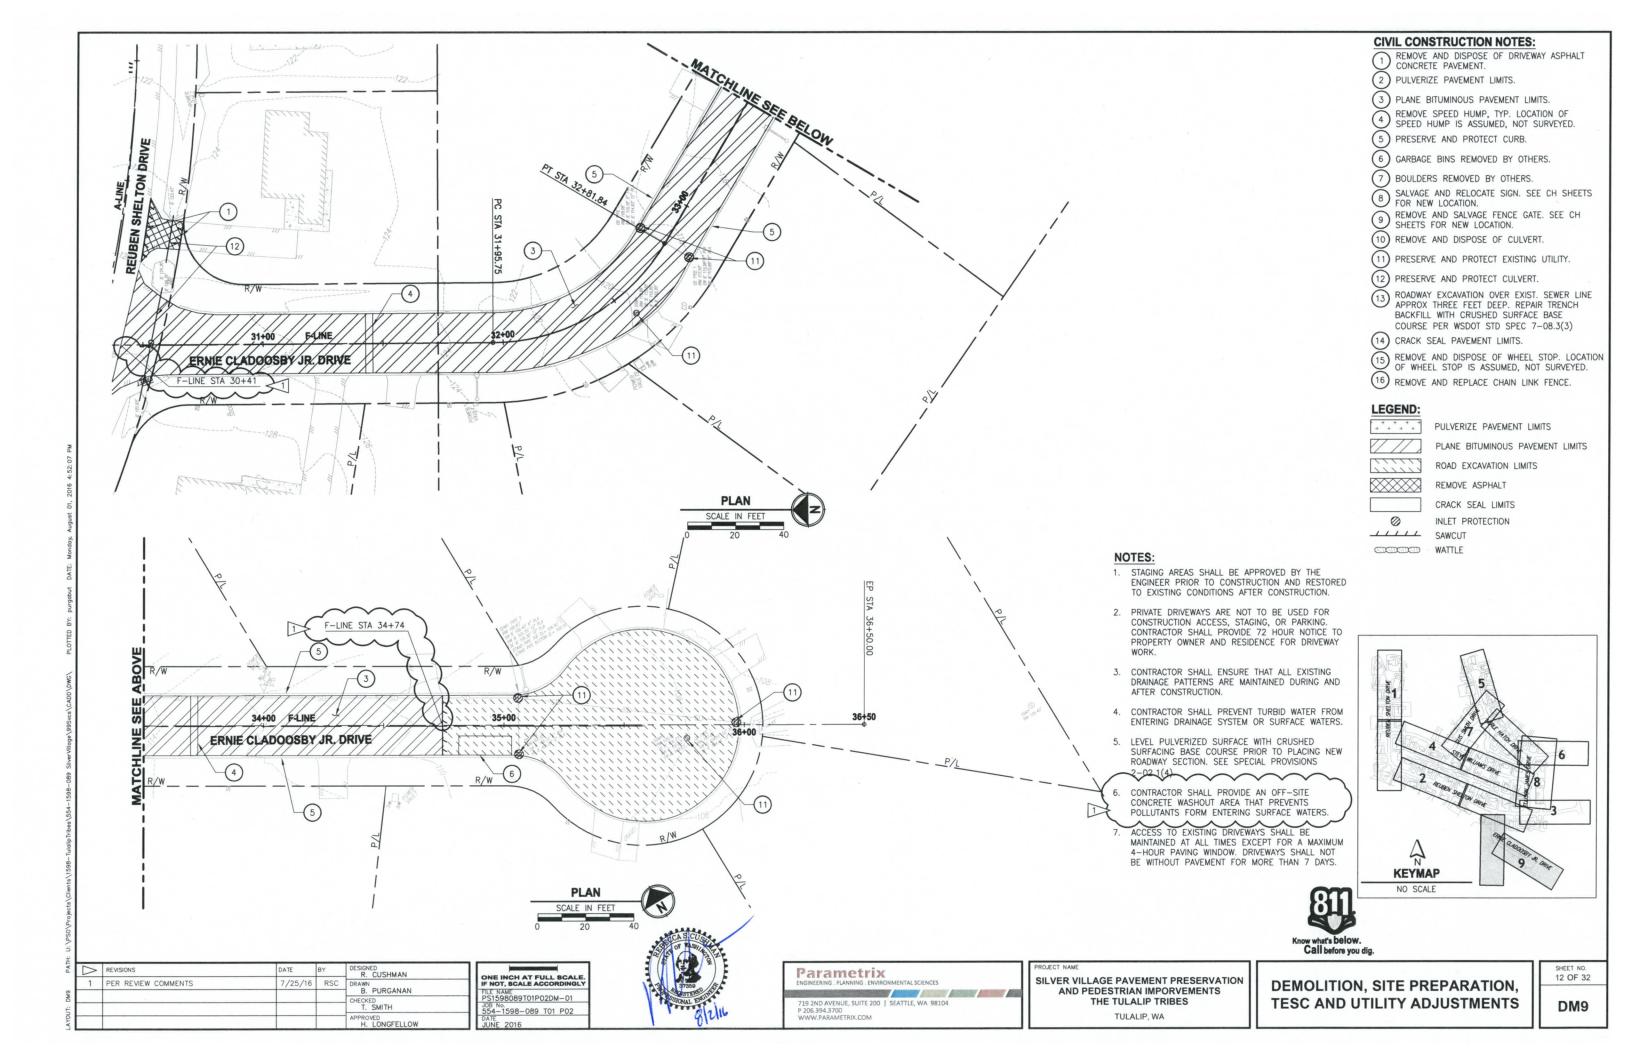

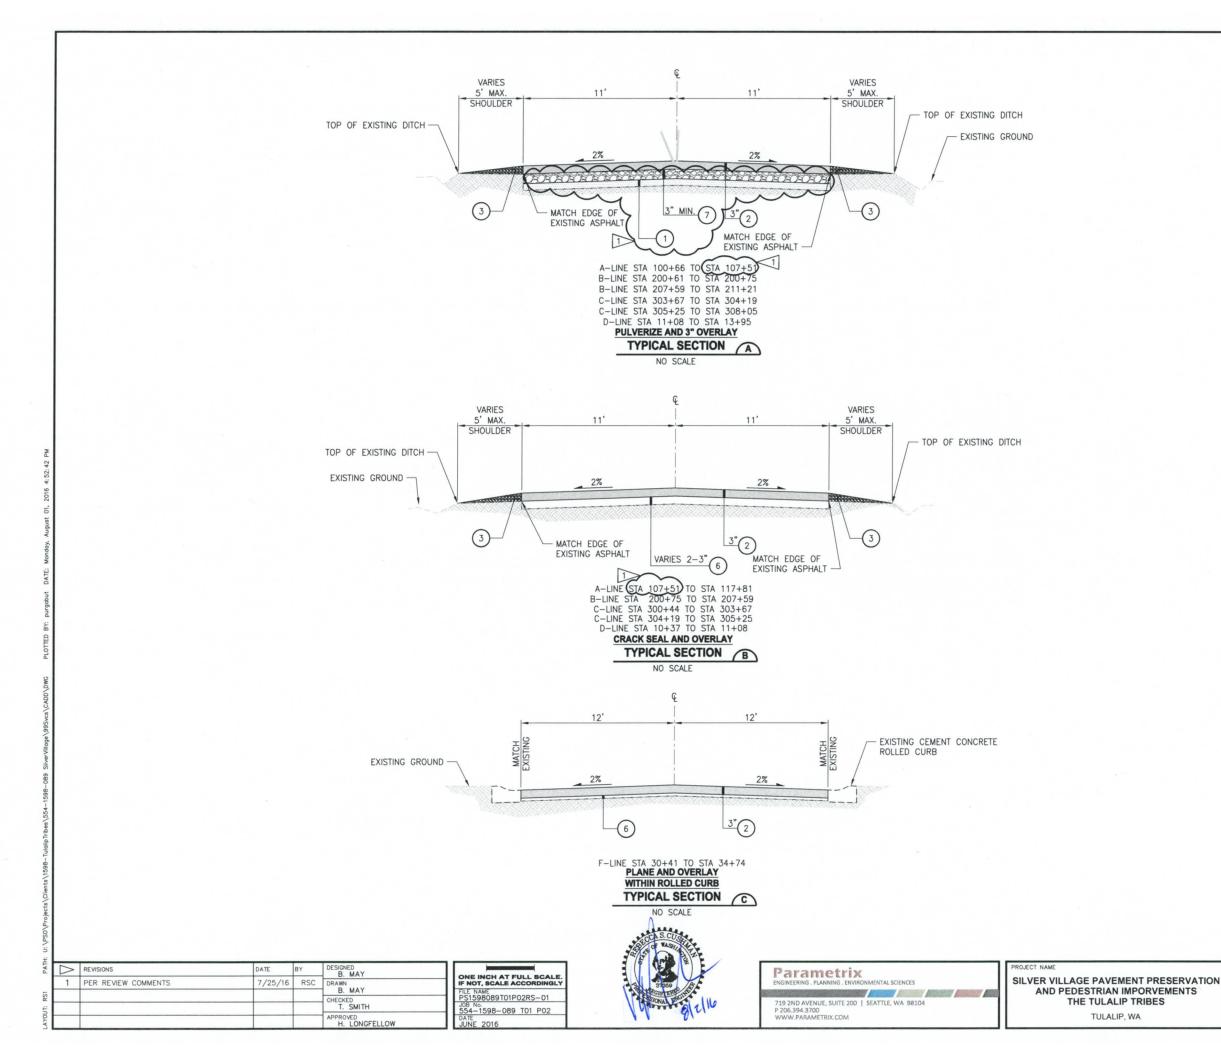

CIVIL CONSTRUCTION NOTES:

PULVERIZED EXISTING ASPHALT CONC PAVEMENT AND CRUSHED SURFACING BASE COURSE. UP TO 2" PULVERIZED ASPHALT CAN COUNT TOWARDS CSBC

(2) HMA CL. 1/2 IN. PG 64-22.

(3) CRUSHED SURFACING TOP COURSE.

CEMENT CONC. TRAFFIC CURB AND GUTTER PER WSDOT STD. PLAN F-10.12-03.

5 CEMENT CONC. SIDEWALK PER WSDOT STD. PLAN F-30.10-03.

(6) EXISTING PAVEMENT.

7) CRUSHED SURFACING BASE COURSE.

(8) SELECT BORROW.

(9) TOP SOIL TYPE A.

NOTES:

- LEVEL PULVERIZED SURFACE WITH CRUSHED SURFACING BASE COURSE PRIOR TO PLACING NEW ROADWAY SECTION. SEE SPECIAL PROVISIONS 2-02.1(4).
- 2. CONTRACTOR SHALL PROVIDE AN OFF-SITE CONCRETE WASHOUT AREA THAT PREVENTS POLLUTANTS FORM ENTERING SURFACE WATERS.
- 3. ALL DEPTHS SHOWN ARE COMPACTED DEPTHS.
- 4. ALL DIMENSIONS ARE IN FEET UNLESS OTHERWISE NOTED.
- 5. SEE CHANNELIZATION AND PAVING PLAN FOR VARIABLE WIDTHS.
- ROADWAY WIDTHS MEASURED FROM CURB FACE, WHERE APPLICABLE.

SEE WSDOT SPEC 5-04.3(5)C FOR CRACK


Know what's below.


Call before you dig.

TYPICAL ROADWAY SECTIONS

RS1

13 OF 32

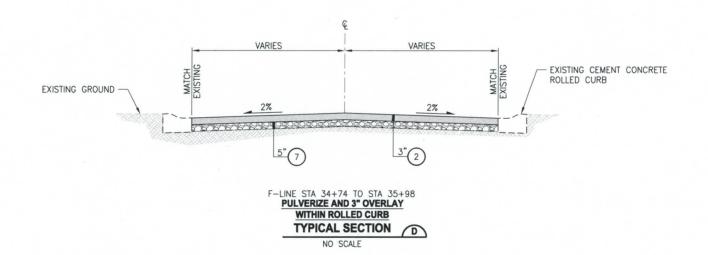

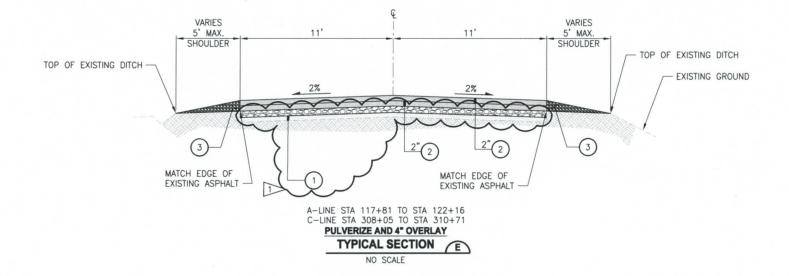

CIVIL CONSTRUCTION NOTES:

PULVERIZED EXISTING ASPHALT CONC

1) PAVEMENT AND CRUSHED SURFACING BASE COURSE. UP TO 2" PULVERIZED ASPHALT CAN COUNT TOWARDS CSBC.

2 HMA CL. 1/2 IN. PG 64-22.

3 CRUSHED SURFACING TOP COURSE.

4 CEMENT CONC. TRAFFIC CURB AND GUTTER PER WSDOT STD. PLAN F-10.12-03.

5 CEMENT CONC. SIDEWALK PER WSDOT STD. PLAN F-30.10-03.

(6) EXISTING PAVEMENT.

(7) CRUSHED SURFACING BASE COURSE.

(8) SELECT BORROW.

(9) TOP SOIL TYPE A.

NOTES:

- LEVEL PULVERIZED SURFACE WITH CRUSHED SURFACING BASE COURSE PRIOR TO PLACING NEW ROADWAY SECTION. SEE SPECIAL PROVISIONS 2-02.1(4).
- 2. CONTRACTOR SHALL PROVIDE AN OFF-SITE CONCRETE WASHOUT AREA THAT PREVENTS POLLUTANTS FORM ENTERING SURFACE WATERS.
- 3. ALL DEPTHS SHOWN ARE COMPACTED
- 4. ALL DIMENSIONS ARE IN FEET UNLESS OTHERWISE NOTED.
- 5. SEE CHANNELIZATION AND PAVING PLAN FOR VARIABLE WIDTHS.
- 6. ROADWAY WIDTHS MEASURED FROM CURB FACE, WHERE APPLICABLE.
- SEE WSDOT SPEC 5-04.3(5)C FOR CRACK

PA	\triangle	REVISIONS	DATE	BY	DESIGNED B. MAY
	1	PER REVIEW COMMENTS	7/25/16	RSC	DRAWN B. MAY
JT: RS2					CHECKED T. SMITH
AYOU					APPROVED H. LONGFELLOW







SILVER VILLAGE PAVEMENT PRESERVATION AND PEDESTRIAN IMPORVEMENTS THE TULALIP TRIBES


TULALIP, WA



TYPICAL ROADWAY SECTIONS

14 OF 32

RS₂

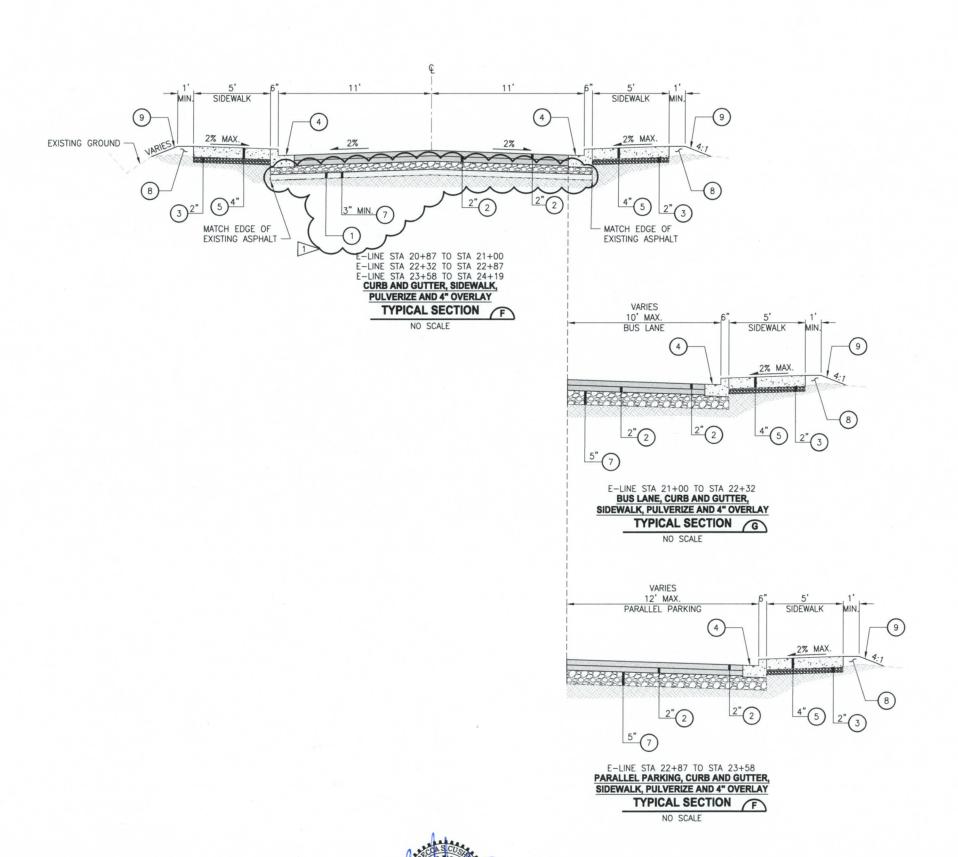

CIVIL CONSTRUCTION NOTES:

PULVERIZED EXISTING ASPHALT CONC PAVEMENT AND CRUSHED SURFACING BASE COURSE. UP TO 2" PULVERIZED ASPHALT CAN COUNT TOWARDS CSBC HMA CL. 1/2 IN. PG 64-22.

(3) CRUSHED SURFACING TOP COURSE.

CEMENT CONC. TRAFFIC CURB AND GUTTER PER WSDOT STD. PLAN F-10.12-03.

5 CEMENT CONC. SIDEWALK PER WSDOT STD. PLAN F-30.10-03.

(6) EXISTING PAVEMENT.

(7) CRUSHED SURFACING BASE COURSE.

(8) SELECT BORROW.

(9) TOP SOIL TYPE A.

NOTES:

- 1. LEVEL PULVERIZED SURFACE WITH CRUSHED SURFACING BASE COURSE PRIOR TO PLACING NEW ROADWAY SECTION. SEE SPECIAL PROVISIONS 2-02.1(4).
- CONTRACTOR SHALL PROVIDE AN OFF-SITE CONCRETE WASHOUT AREA THAT PREVENTS POLLUTANTS FORM ENTERING SURFACE WATERS.
- 3. ALL DEPTHS SHOWN ARE COMPACTED DEPTHS.
- 4. ALL DIMENSIONS ARE IN FEET UNLESS OTHERWISE NOTED.
- 5. SEE CHANNELIZATION AND PAVING PLAN FOR VARIABLE WIDTHS.
- 6. ROADWAY WIDTHS MEASURED FROM CURB FACE, WHERE APPLICABLE.

7. SEE WSDOT SPEC 5-04.3(5)C FOR CRACK



Know what's below. Call before you dig.

REVISIONS B. MAY PER REVIEW COMMENTS 7/25/16 B. MAY PPROVED H. LONGFELLOW

ONE INCH AT FULL SCALE
IF NOT, SCALE ACCORDINGLY \$1598089T01P02RS-01 554-1598-089 T01 P02



Parametrix


SILVER VILLAGE PAVEMENT PRESERVATION AND PEDESTRIAN IMPORVEMENTS THE TULALIP TRIBES

TULALIP, WA

TYPICAL ROADWAY SECTIONS


15 OF 32


RS₃

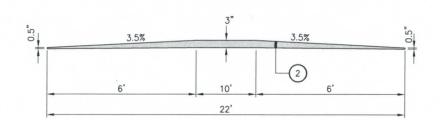

CROSS SECTION (A) NO SCALE

EDGE OF PAVEMENT -SHOULDER -MUTCH W17-1 SIGN CENTER OF TRAVEL LANE - MUTCH W17-1 SIGN (TYP) - SPEED BUMP SYMBOL PER WSDOT STD. PLAN M-24.60-04.

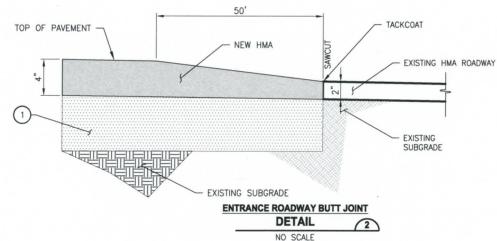

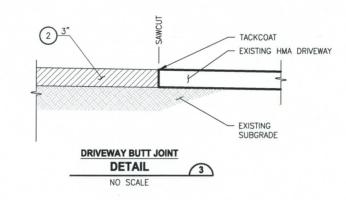

CIVIL CONSTRUCTION NOTES:

PULVERIZED EXISTING ASPHALT CONC PAVEMENT AND CRUSHED SURFACING BASE COURSE. UP TO 2" PULVERIZED ASPHALT CAN COUNT TOWARDS CSBC.

2 HMA CL. 1/2 IN. PG 64-22.

3 CRUSHED SURFACING TOP COURSE.

CEMENT CONC. TRAFFIC CURB AND GUTTER PER WSDOT STD. PLAN F-10.12-03.

5 CEMENT CONC. SIDEWALK PER WSDOT STD. PLAN F-30.10-03.

(6) EXISTING PAVEMENT.

(7) CRUSHED SURFACING BASE COURSE.

(8) SELECT BORROW.

(9) TOP SOIL TYPE A.

NOTES:

- 1. LEVEL PULVERIZED SURFACE WITH CRUSHED SURFACING BASE COURSE PRIOR TO PLACING NEW ROADWAY SECTION. SEE SPECIAL PROVISIONS 2-02.1(4).
- 2. CONTRACTOR SHALL PROVIDE AN OFF-SITE CONCRETE WASHOUT AREA THAT PREVENTS POLLUTANTS FORM ENTERING SURFACE WATERS.
- 3. ALL DEPTHS SHOWN ARE COMPACTED DEPTHS.
- 4. ALL DIMENSIONS ARE IN FEET UNLESS OTHERWISE NOTED.
- 5. SEE CHANNELIZATION AND PAVING PLAN FOR VARIABLE WIDTHS.
- 6. ROADWAY WIDTHS MEASURED FROM CURB FACE, WHERE APPLICABLE.

SEE WSDOT SPEC 5-04.3(5)C FOR CRACK SEALING.

SPEED BUMP DETAIL NO SCALE

Parametrix 719 2ND AVENUE, SUITE 200 | SEATTLE, WA 98104 P 206.394.3700 WWW.PARAMETRIX.COM

SILVER VILLAGE PAVEMENT PRESERVATION AND PEDESTRIAN IMPORVEMENTS THE TULALIP TRIBES

TULALIP, WA

TYPICAL ROADWAY SECTIONS

Know what's below.
Call before you dig.

16 OF 32


RS4


REVISIONS


PER REVIEW COMMENTS 7/25/16 RSC B. MAY T. SMITH APPROVED
H. LONGFELLOW


DESIGNED B. MAY

ONE INCH AT FULL SCALE FILE NAME PS1598089T01P02RS-01 JOB No. 554-1598-089 T01 P02

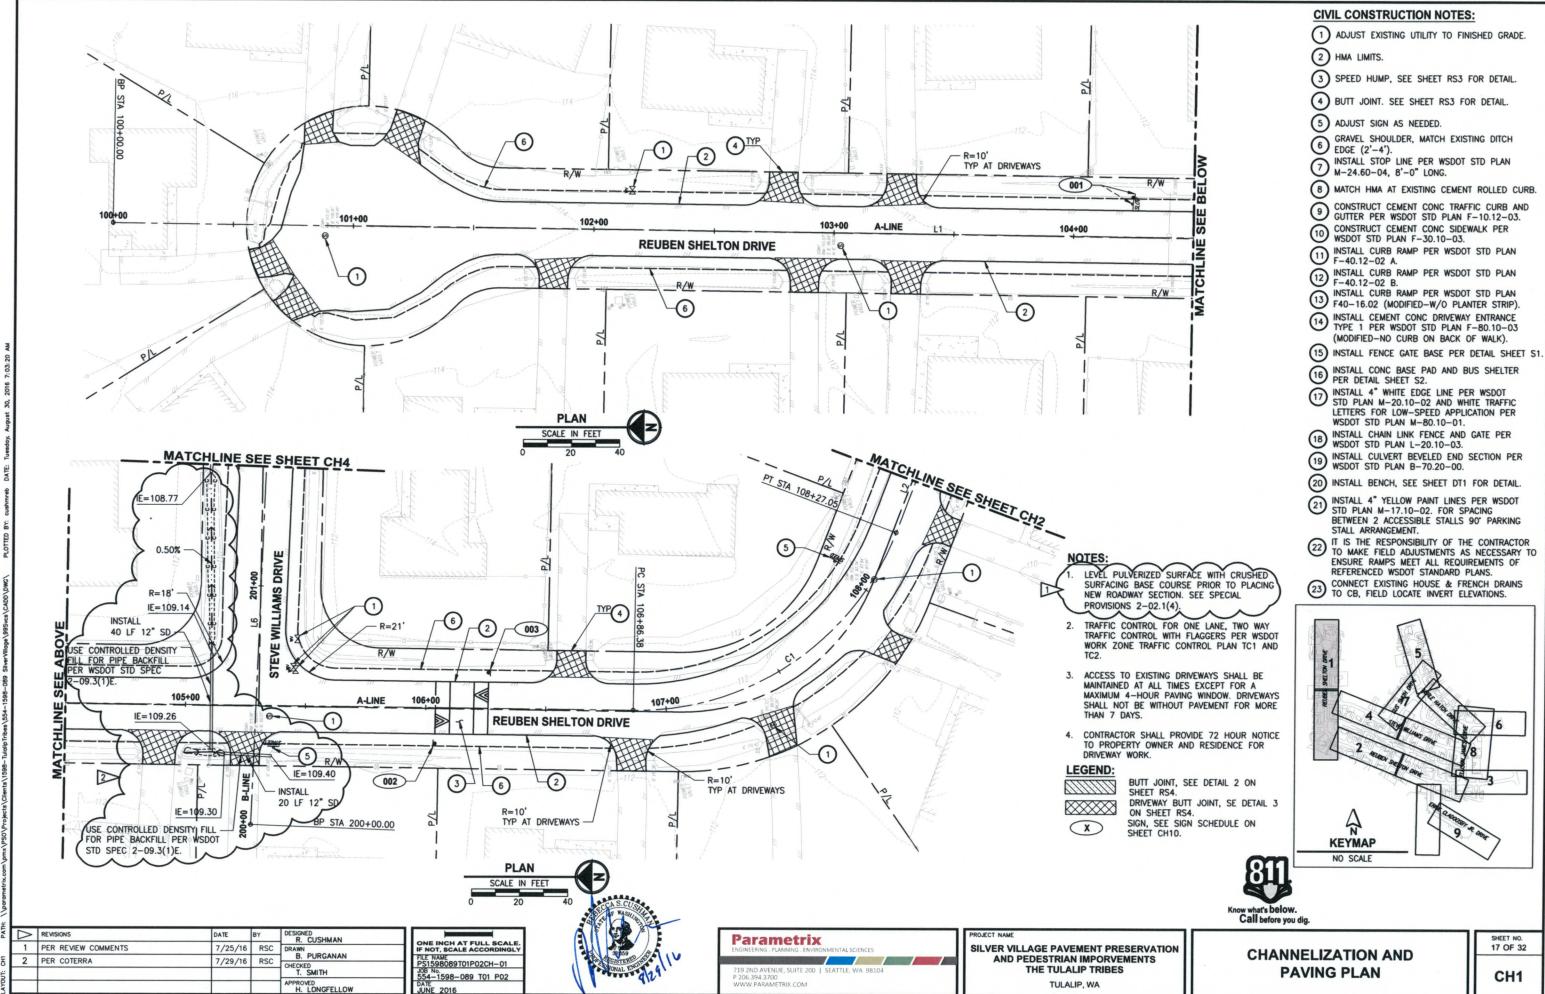

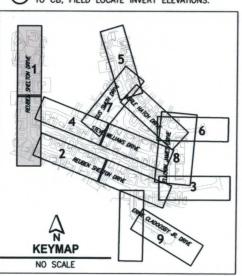

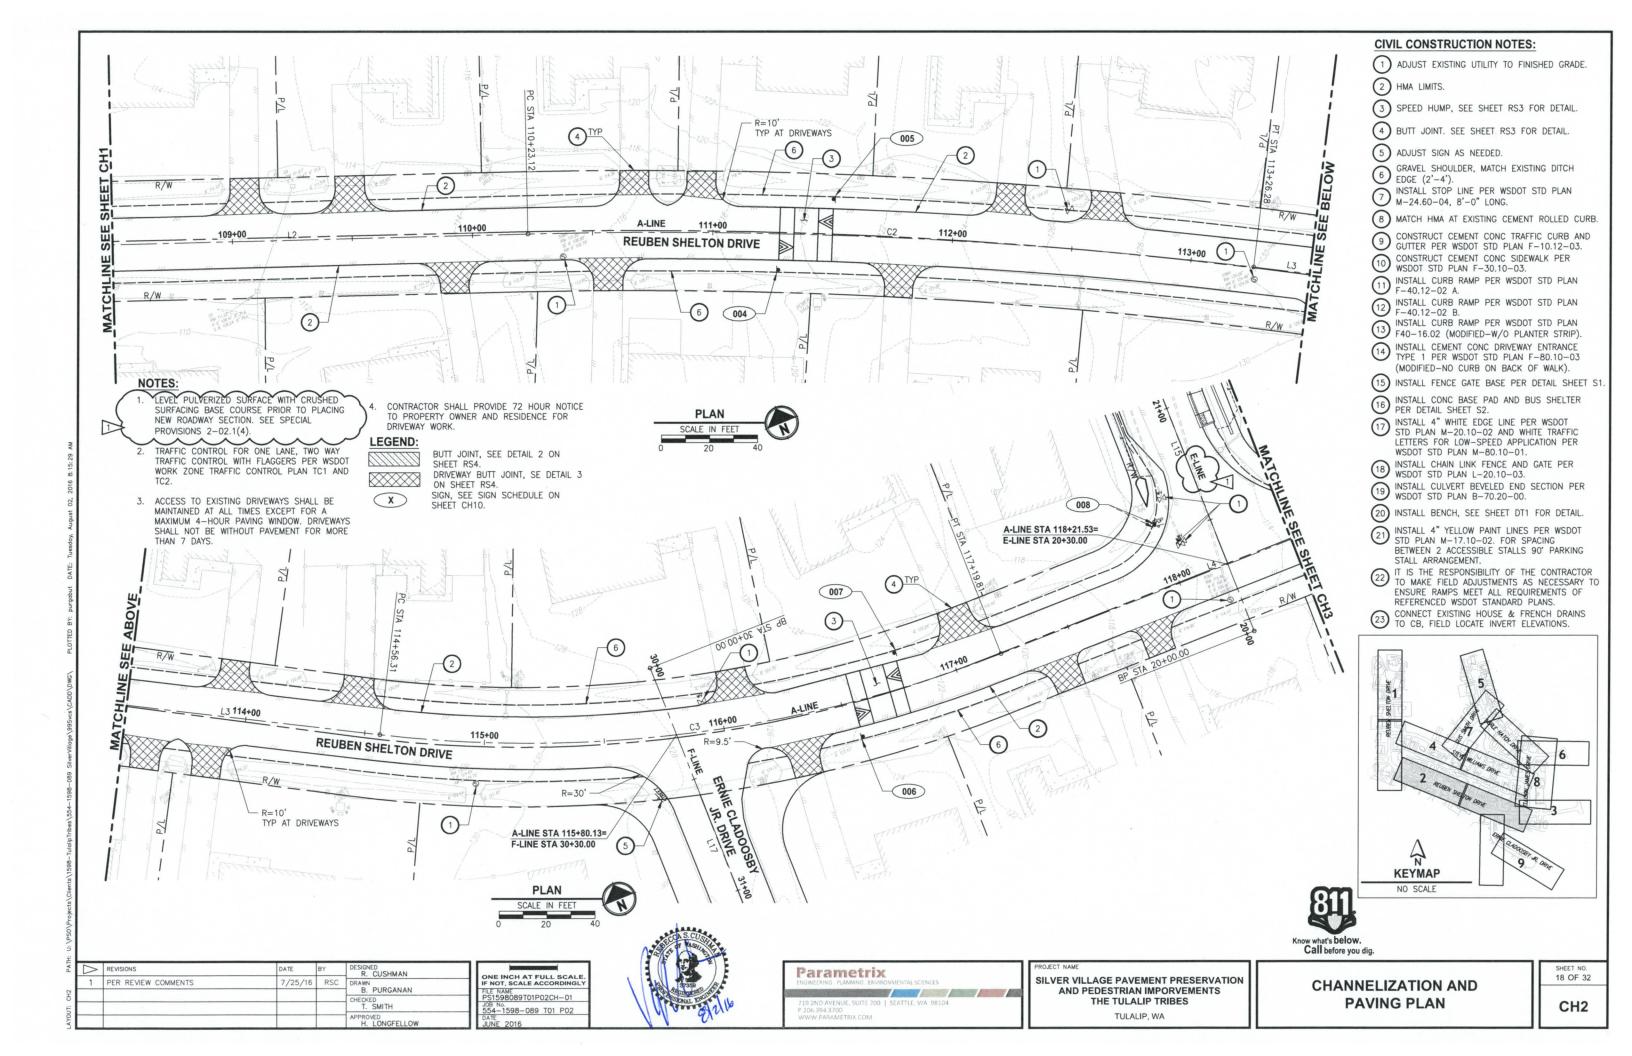

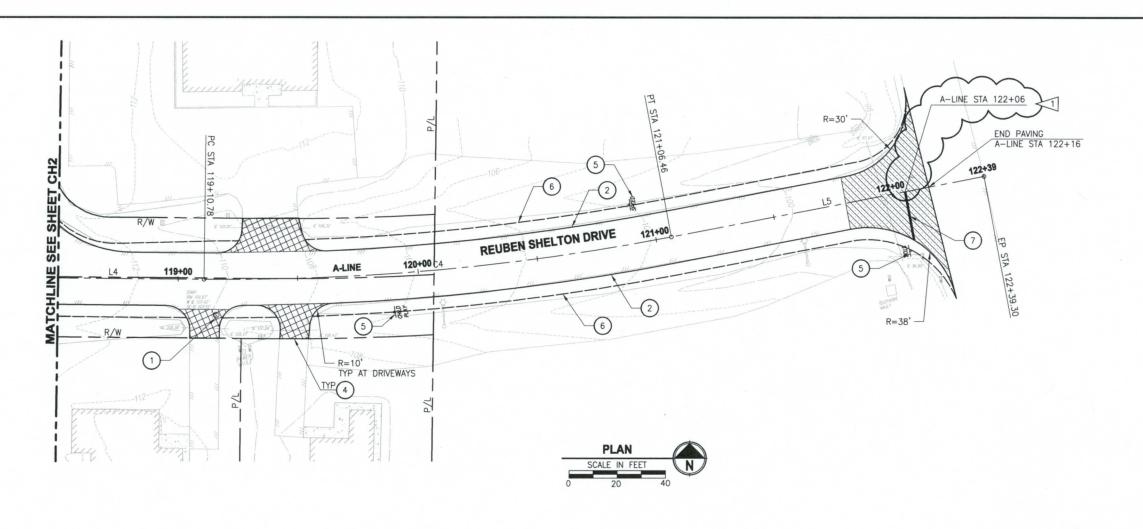

NOTES:

LEVEL PULVERIZED SURFACE WITH CRUSHED SURFACING BASE COURSE PRIOR TO PLACING NEW ROADWAY SECTION. SEE SPECIAL PROVISIONS 2-02.1(4).

2. TRAFFIC CONTROL FOR ONE LANE, TWO WAY TRAFFIC CONTROL WITH FLAGGERS PER WSDOT WORK ZONE TRAFFIC CONTROL PLAN TC1 AND TC2.

 ACCESS TO EXISTING DRIVEWAYS SHALL BE MAINTAINED AT ALL TIMES EXCEPT FOR A MAXIMUM 4-HOUR PAVING WINDOW. DRIVEWAYS SHALL NOT BE WITHOUT PAVEMENT FOR MORE THAN 7 DAYS.

 CONTRACTOR SHALL PROVIDE 72 HOUR NOTICE TO PROPERTY OWNER AND RESIDENCE FOR DRIVEWAY WORK.

LEGEND:


BUTT JOINT, SEE DETAIL 2 ON SHEET RS4.

 \mathbf{x}

DRIVEWAY BUTT JOINT, SE DETAIL 3 ON SHEET RS4. SIGN, SEE SIGN SCHEDULE ON SHEET CH10.

CIVIL CONSTRUCTION NOTES:

- 1) ADJUST EXISTING UTILITY TO FINISHED GRADE.
- 2 HMA LIMITS.
- 3 SPEED HUMP, SEE SHEET RS3 FOR DETAIL.
- (4) BUTT JOINT. SEE SHEET RS3 FOR DETAIL.
- (5) ADJUST SIGN AS NEEDED.
- GRAVEL SHOULDER, MATCH EXISTING DITCH EDGE (2'-4').
- 7) INSTALL STOP LINE PER WSDOT STD PLAN M-24.60-04, 8'-0" LONG.
- (8) MATCH HMA AT EXISTING CEMENT ROLLED CURB.
- CONSTRUCT CEMENT CONC TRAFFIC CURB AND GUTTER PER WSDOT STD PLAN F-10.12-03.
- 10 CONSTRUCT CEMENT CONC SIDEWALK PER WSDOT STD PLAN F-30.10-03.
- 11) INSTALL CURB RAMP PER WSDOT STD PLAN F-40.12-02 A.
- 12 INSTALL CURB RAMP PER WSDOT STD PLAN F-40.12-02 B.
- INSTALL CURB RAMP PER WSDOT STD PLAN F40-16.02 (MODIFIED-W/O PLANTER STRIP).
- 14) INSTALL CEMENT CONC DRIVEWAY ENTRANCE
 TYPE 1 PER WSDOT STD PLAN F-80.10-03
 (MODIFIED-NO CURB ON BACK OF WALK).
- (15) INSTALL FENCE GATE BASE PER DETAIL SHEET S1.
- 16 INSTALL CONC BASE PAD AND BUS SHELTER PER DETAIL SHEET S2.
- 17) INSTALL 4" WHITE EDGE LINE PER WSDOT STD PLAN M-20.10-02 AND WHITE TRAFFIC LETTERS FOR LOW-SPEED APPLICATION PER WSDOT STD PLAN M-80.10-01.
- 18 INSTALL CHAIN LINK FENCE AND GATE PER WSDOT STD PLAN L-20.10-03.
- 19 INSTALL CULVERT BEVELED END SECTION PER WSDOT STD PLAN B-70.20-00.
- (20) INSTALL BENCH, SEE SHEET DT1 FOR DETAIL.
- 21 INSTALL 4" YELLOW PAINT LINES PER WSDOT STD PLAN M-17.10-02. FOR SPACING BETWEEN 2 ACCESSIBLE STALLS 90' PARKING STALL ARRANGEMENT.
- IT IS THE RESPONSIBILITY OF THE CONTRACTOR TO MAKE FIELD ADJUSTMENTS AS NECESSARY TO ENSURE RAMPS MEET ALL REQUIREMENTS OF REFERENCED WSDOT STANDARD PLANS.
- CONNECT EXISTING HOUSE & FRENCH DRAINS TO CB, FIELD LOCATE INVERT ELEVATIONS.

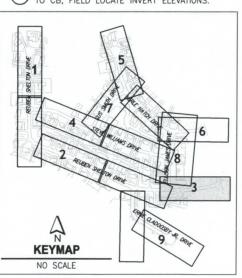



REVISIONS

DATE
BY
DESIGNED
R. CUSHMAN
DESIGNED
R. CUSHMAN
DESIGNED
R. CUSHMAN
B. PURGANAN
CHECKED
CHECKED
T. SMITH
APPROVED
H. LONGFELLOW

ONE INCH AT FULL SCALE.
IF NOT, SCALE ACCORDINGLY
FILE NAME
PS1598009701P02CH-01
J08 No.
554-1598-089 T01 P02
DATE
JUNE 2016





PROJECT NA


SILVER VILLAGE PAVEMENT PRESERVATION AND PEDESTRIAN IMPORVEMENTS THE TULALIP TRIBES


TULALIP, WA

CHANNELIZATION AND PAVING PLAN


SHEET NO. 19 OF 32


CH3

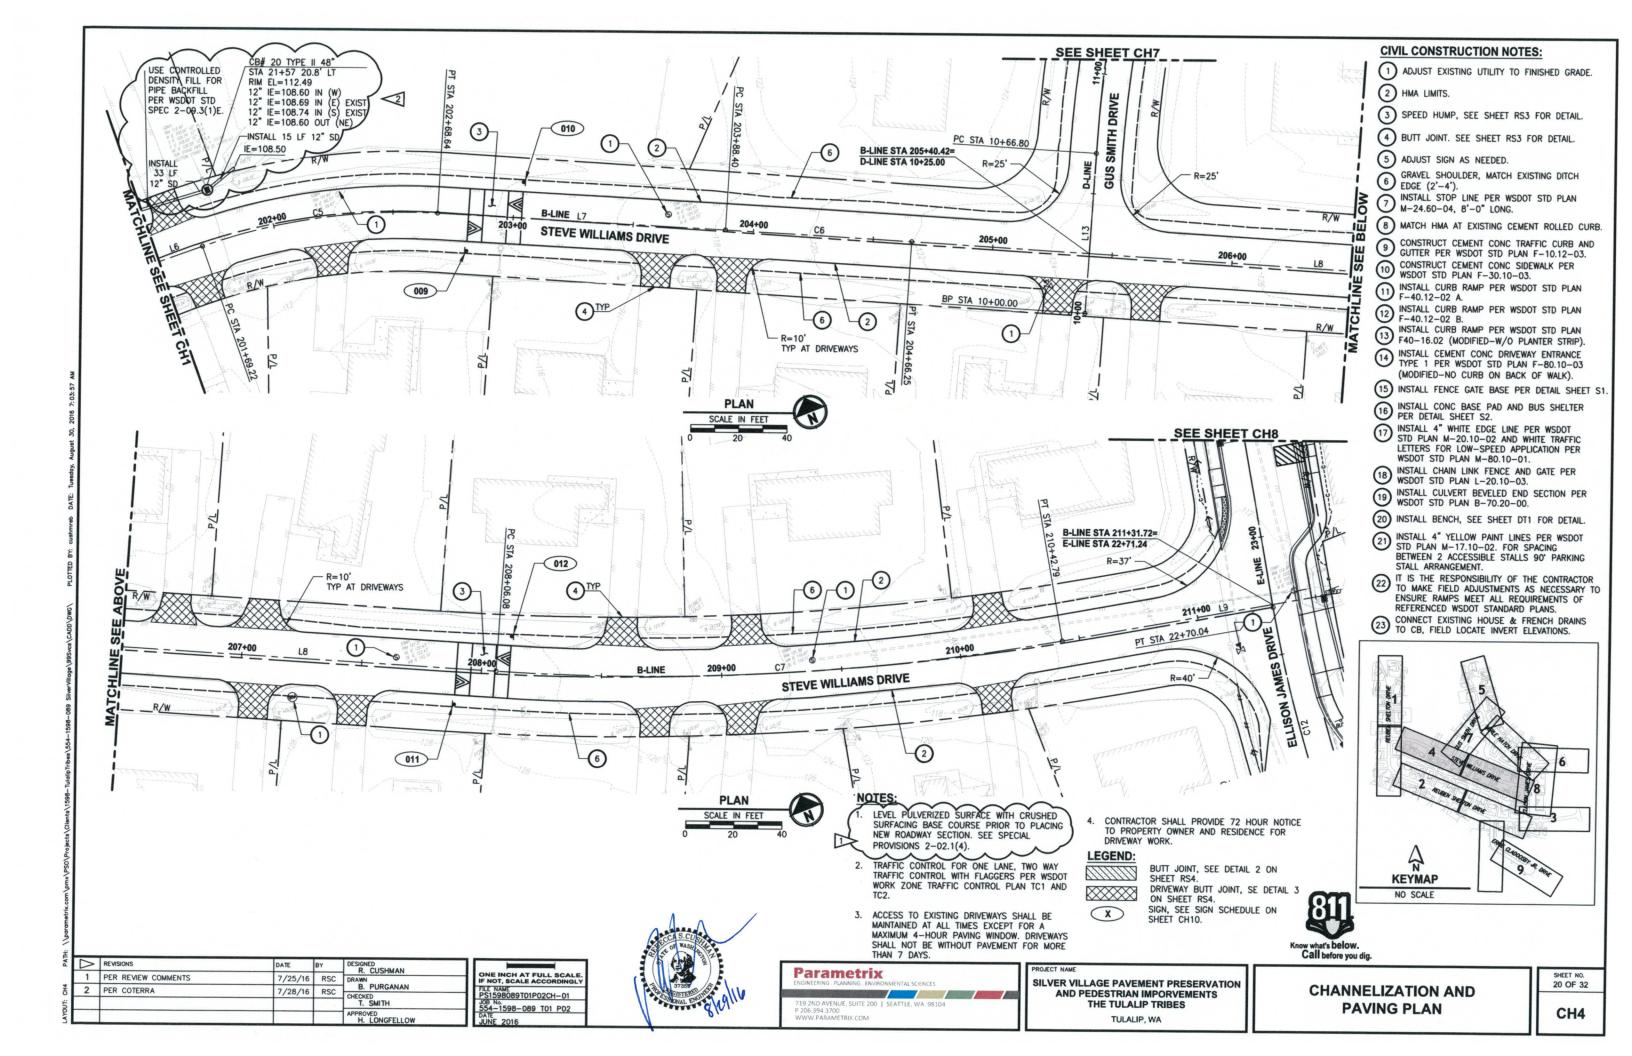

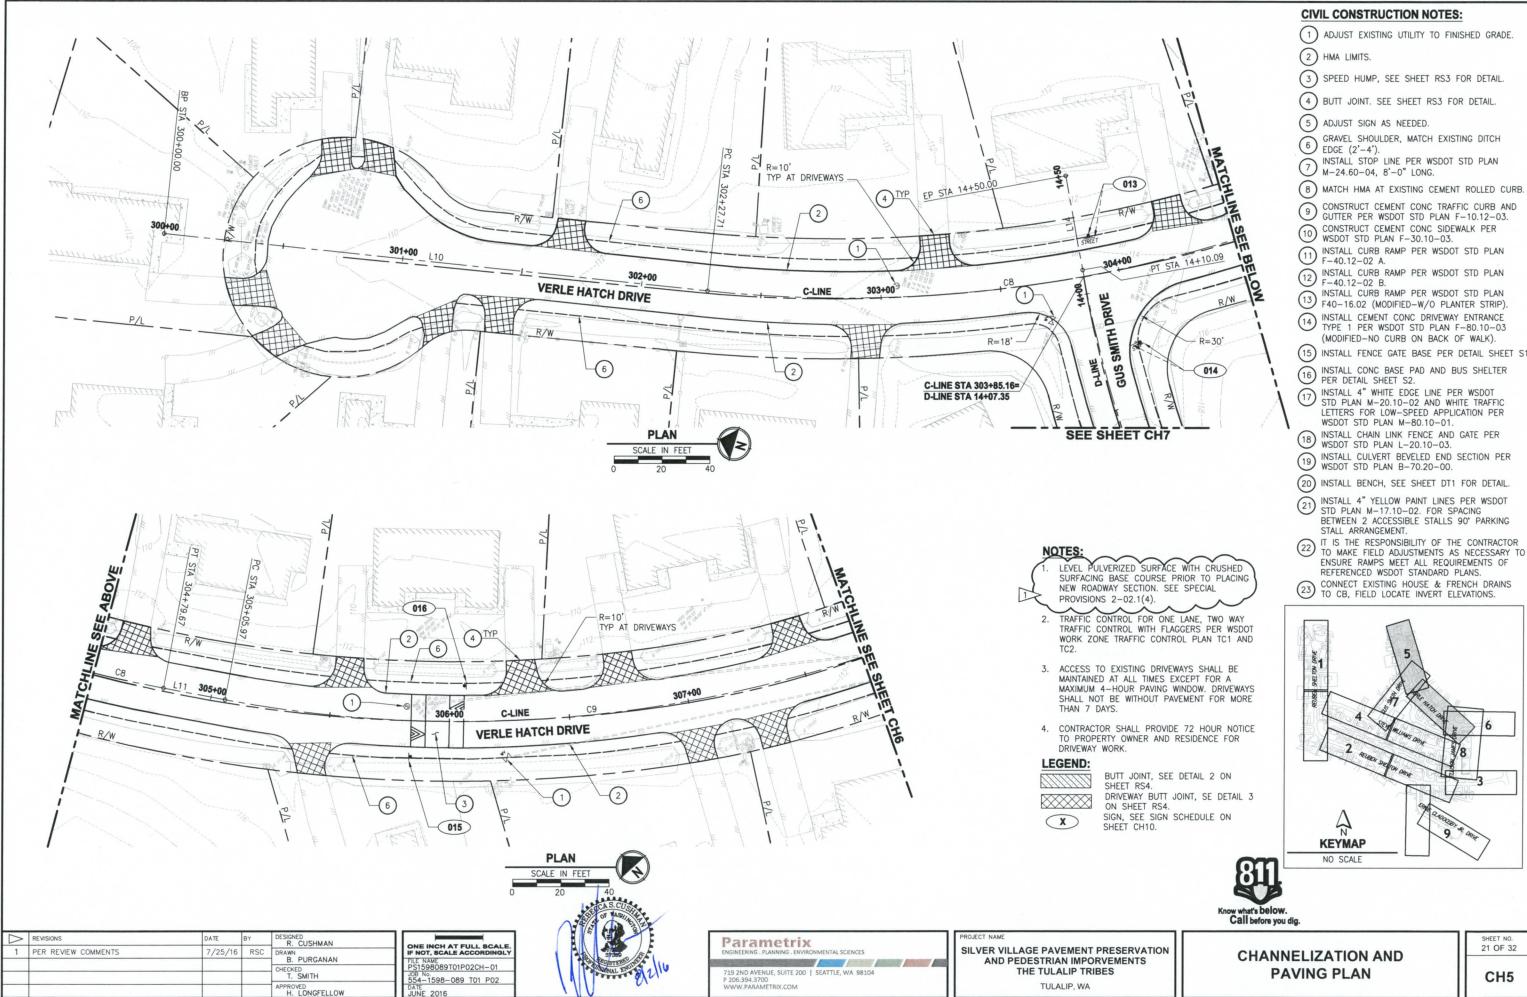

(15) INSTALL FENCE GATE BASE PER DETAIL SHEET S1.

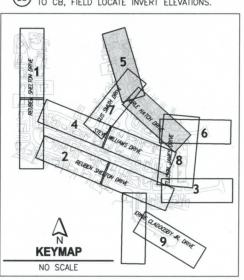

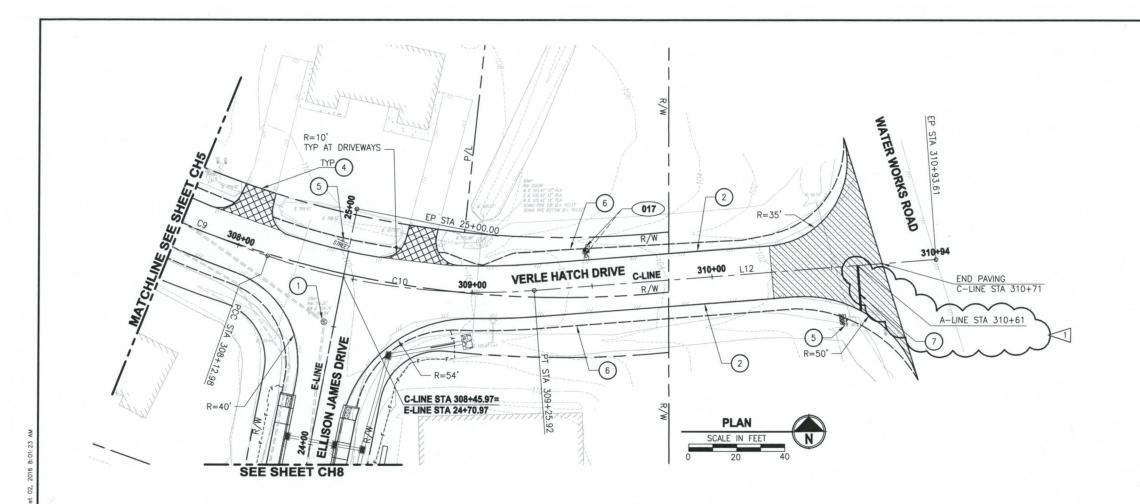

NOTES:

LEVEL PULVERIZED SURFACE WITH CRUSHED SURFACING BASE COURSE PRIOR TO PLACING NEW ROADWAY SECTION. SEE SPECIAL PROVISIONS 2-02.1(4).

TRAFFIC CONTROL FOR ONE LANE, TWO WAY TRAFFIC CONTROL WITH FLAGGERS PER WSDOT WORK ZONE TRAFFIC CONTROL PLAN TC1 AND

3. ACCESS TO EXISTING DRIVEWAYS SHALL BE MAINTAINED AT ALL TIMES EXCEPT FOR A MAXIMUM 4-HOUR PAVING WINDOW. DRIVEWAYS SHALL NOT BE WITHOUT PAVEMENT FOR MORE THAN 7 DAYS.

4. CONTRACTOR SHALL PROVIDE 72 HOUR NOTICE TO PROPERTY OWNER AND RESIDENCE FOR DRIVEWAY WORK.

LEGEND:

BUTT JOINT, SEE DETAIL 2 ON SHEET RS4.


DRIVEWAY BUTT JOINT, SE DETAIL 3 ON SHEET RS4.

 $\langle X \rangle$

SIGN, SEE SIGN SCHEDULE ON SHEET CH10.

CIVIL CONSTRUCTION NOTES:

- (1) ADJUST EXISTING UTILITY TO FINISHED GRADE.
- (2) HMA LIMITS.
- 3) SPEED HUMP, SEE SHEET RS3 FOR DETAIL.
- (4) BUTT JOINT. SEE SHEET RS3 FOR DETAIL.
- (5) ADJUST SIGN AS NEEDED.
- 6 GRAVEL SHOUL EDGE (2'-4'). GRAVEL SHOULDER, MATCH EXISTING DITCH
- INSTALL STOP LINE PER WSDOT STD PLAN M-24.60-04, 8'-0" LONG.
- (8) MATCH HMA AT EXISTING CEMENT ROLLED CURB.
- 9 CONSTRUCT CEMENT CONC TRAFFIC CURB AND GUTTER PER WSDOT STD PLAN F-10.12-03.
- 10 CONSTRUCT CEMENT CONC SIDEWALK PER WSDOT STD PLAN F-30.10-03.
- $\overbrace{\mbox{11}} \mbox{ INSTALL CURB RAMP PER WSDOT STD PLAN} \\ \mbox{F-40.12-02 A}.$ 12 INSTALL CURB RAMP PER WSDOT STD PLAN F-40.12-02 B.
- 13 INSTALL CURB RAMP PER WOOD STORES STRIP).
- 14 INSTALL CEMENT CONC DRIVEWAY ENTRANCE (MODIFIED-NO CURB ON BACK OF WALK).
- (15) INSTALL FENCE GATE BASE PER DETAIL SHEET S1.
- 16 INSTALL CONC BASE PAD AND BUS SHELTER PER DETAIL SHEET S2.
- 17 INSTALL 4" WHITE EDGE LINE PER WSDOT STD PLAN M-20.10-02 AND WHITE TRAFFIC LETTERS FOR LOW-SPEED APPLICATION PER WSDOT STD PLAN M-80.10-01.
- (18) INSTALL CHAIN LINK FENCE AND GATE PER WSDOT STD PLAN L-20.10-03.
- 19 INSTALL CULVERT BEVELED END SECTION PER WSDOT STD PLAN B-70.20-00.
- (20) INSTALL BENCH, SEE SHEET DT1 FOR DETAIL.
- 21 INSTALL 4" YELLOW PAINT LINES PER WSDOT STD PLAN M-17.10-02. FOR SPACING BETWEEN 2 ACCESSIBLE STALLS 90° PARKING STALL ARRANGEMENT.
- IT IS THE RESPONSIBILITY OF THE CONTRACTOR TO MAKE FIELD ADJUSTMENTS AS NECESSARY TO ENSURE RAMPS MEET ALL REQUIREMENTS OF REFERENCED WSDOT STANDARD PLANS.
- CONNECT EXISTING HOUSE & FRENCH DRAINS TO CB, FIELD LOCATE INVERT ELEVATIONS.

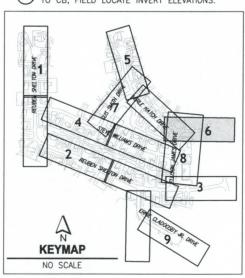

Know what's below.
Call before you dig.

	REVISIONS	DATE	BY	DESIGNED R. CUSHMAN
1	PER REVIEW COMMENTS	7/25/16	RSC	DRAWN B. PURGANAN
				CHECKED T. SMITH
				APPROVED H. LONGFELLOW

]	ONE INCH AT FULL SCALE.
	IF NOT, SCALE ACCORDINGLY
1	FILE NAME PS1598089T01P02CH-01
1	JOB No. 554-1598-089 T01 P02
	JUNE 2016



ENGINEERING . PLANNING . ENVIRONMENTAL SCIENCES	SILVER VI
719 2ND AVENUE, SUITE 200 SEATTLE, WA 98104 P 206.394.3700	AND
WWW.PARAMETRIX.COM	11

PROJECT NAME


VILLAGE PAVEMENT PRESERVATION PEDESTRIAN IMPORVEMENTS THE TULALIP TRIBES

TULALIP, WA

CHANNELIZATION AND PAVING PLAN

22 OF 32

CH₆

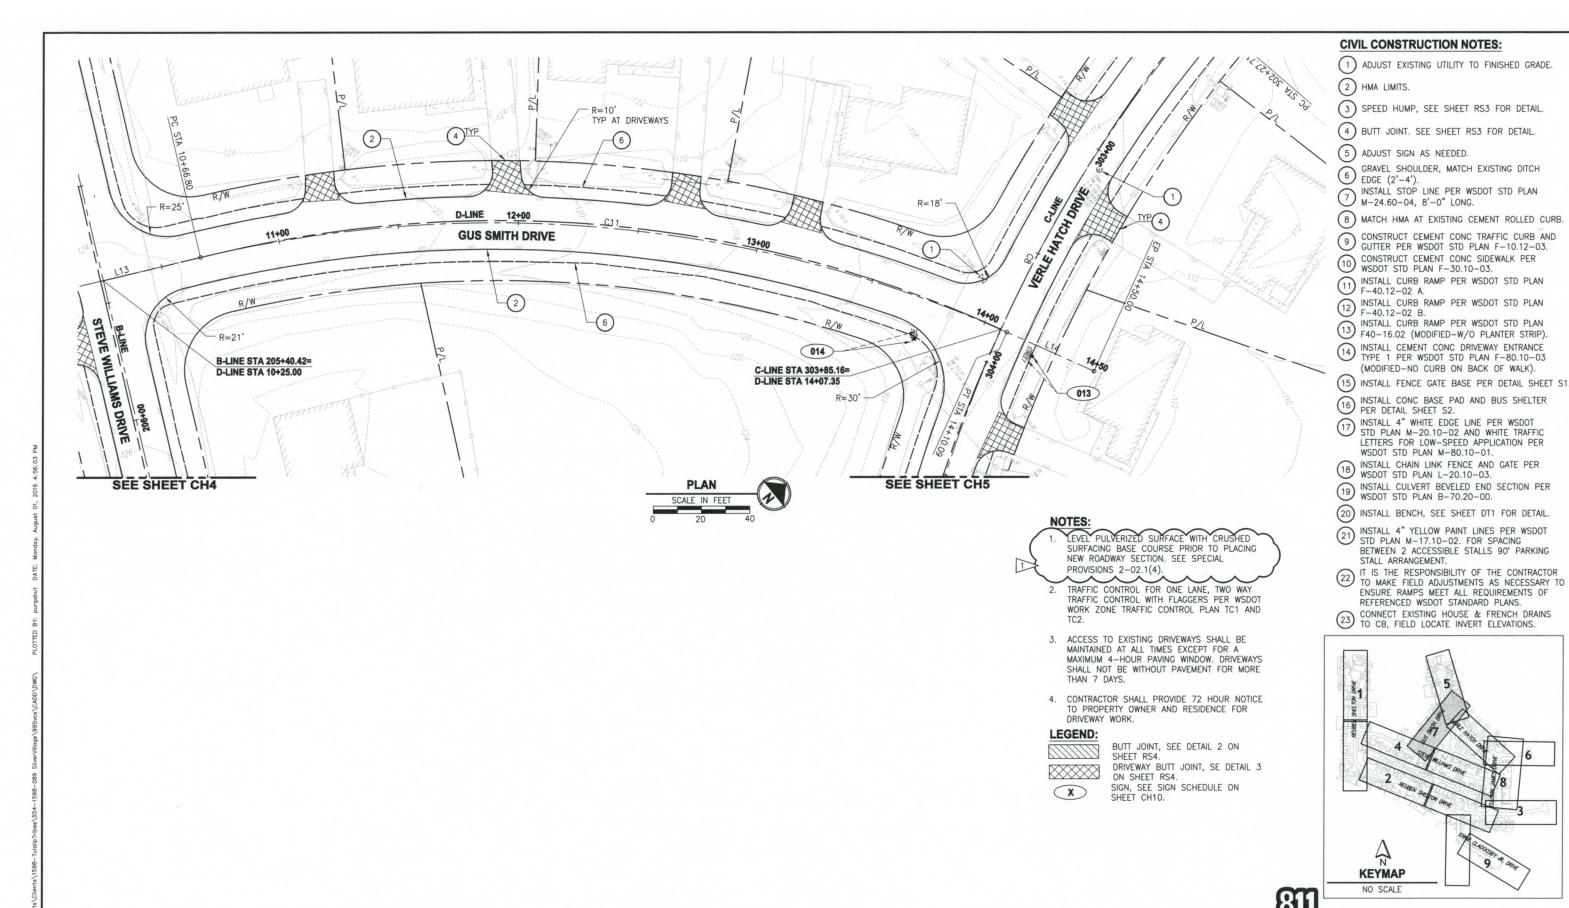

REVISIONS R. CUSHMAN PER REVIEW COMMENTS 7/25/16 B. PURGANAN HECKED T. SMITH PPROVED
H. LONGFELLOW

ONE INCH AT FULL SCALE
IF NOT, SCALE ACCORDINGL 1598089T01P02CH-01 554-1598-089 T01 P02





SILVER VILLAGE PAVEMENT PRESERVATION AND PEDESTRIAN IMPORVEMENTS THE TULALIP TRIBES


TULALIP, WA


Know what's below. Call before you dig.


CHANNELIZATION AND PAVING PLAN

23 OF 32

CH7

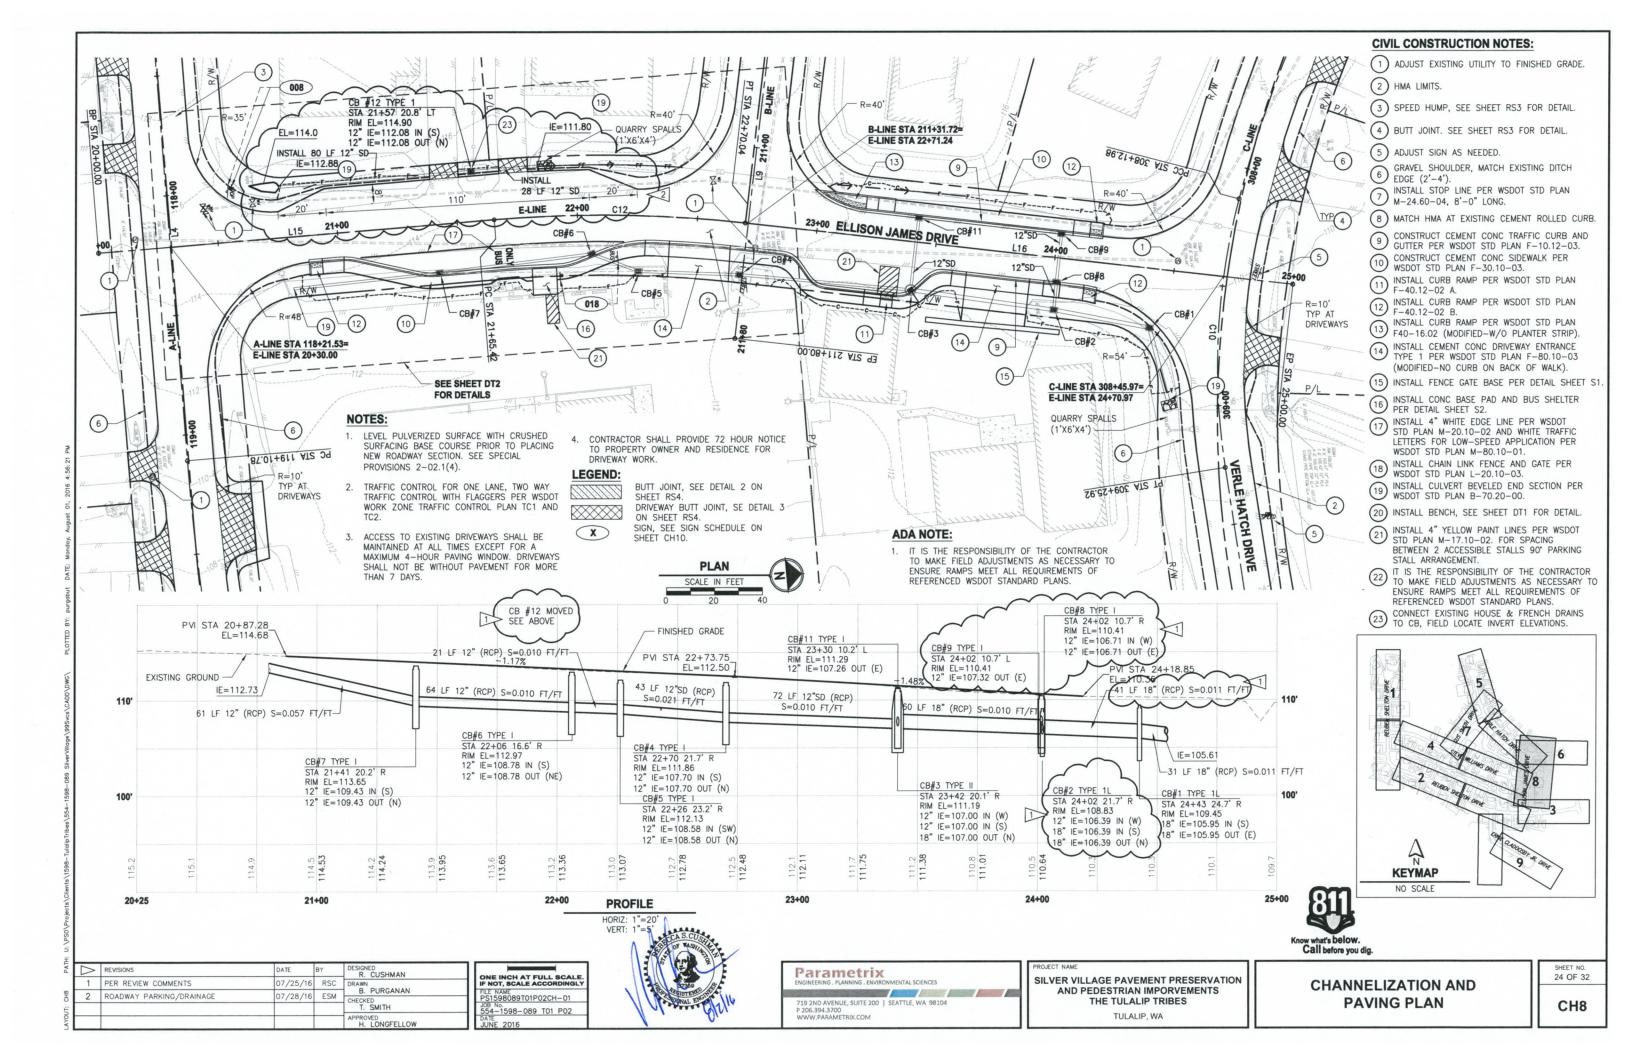

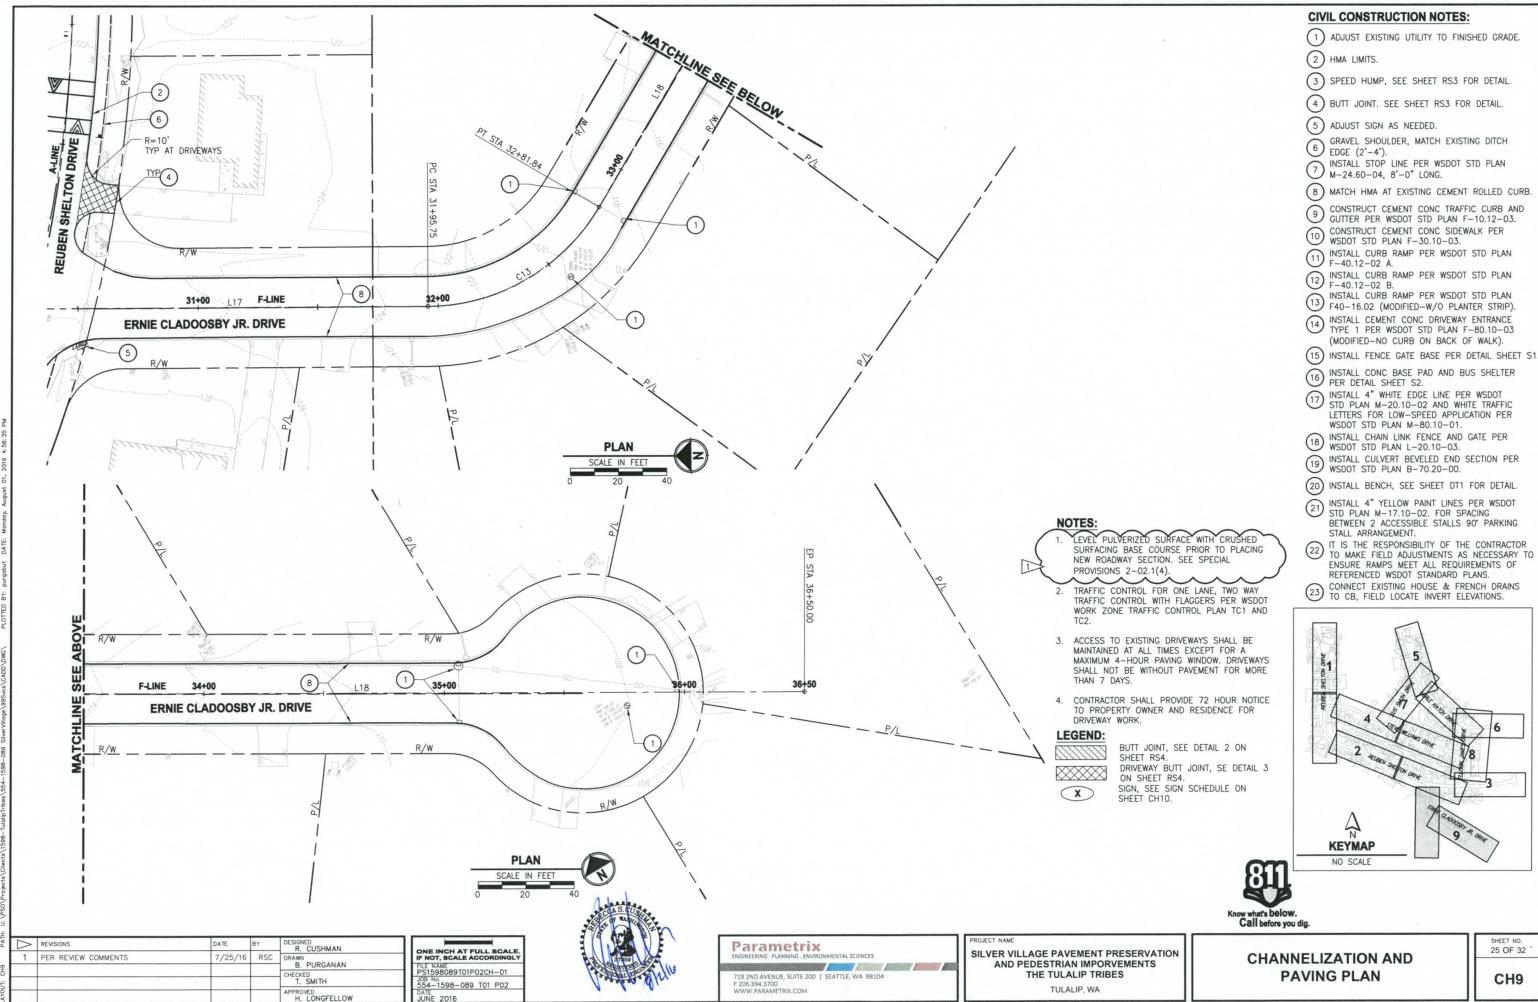

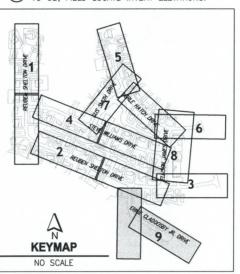

SIGN SCHEDULE

SIGN		LOCATION		DECORIDATION	MUTCD SIGN	SIGN SIZE	POST TYPE	POST SIZE/TYPE	REMARK
NUMBER	ALIGNMENT	STATION	OFFSET	DESCRIPTION	MUTCD SIGN	SIGN SIZE	POST TIPE	POST SIZE/TIPE	REMARK
001	A-LINE	104+25	16.5' LT	SLOW CHILDREN AT PLAY	CUSTOM	N/A	N/A	N/A	RELOCATE EXISTING SIGN AND POST
002	A-LINE	106+04	15.0' RT	SPEED HUMP	W17-1	30" X 30"	N/A	4"X 4", WOOD	NEW SIGN AND POST
003	A-LINE	106+26	15.0' LT	SPEED HUMP	W17-1	30" X 30"	N/A	4"X 4", WOOD	NEW SIGN AND POST
004	A-LINE	111+27	15.0' RT	SPEED HUMP	W17-1	30" X 30"	N/A	4"X 4", WOOD	NEW SIGN AND POST
005	A-LINE	111+50	15.0' LT	SPEED HUMP	W17-1	30" X 30"	N/A	4"X 4", WOOD	NEW SIGN AND POST
006	A-LINE	116+55	15.0' RT	SPEED HUMP	W17-1	30" X 30"	N/A	4"X 4", WOOD	NEW SIGN AND POST
007	A-LINE	116+78	15.0' LT	SPEED HUMP	W17-1	30" X 30"	N/A	4"X 4", WOOD	NEW SIGN AND POST
008	A-LINE	117+99	26.8' LT	STOP	R1-1	N/A	N/A	N/A	RELOCATE EXISTING SIGN AND POST
009	B-LINE	202+81	15.0' RT	SPEED HUMP	W17-1	30" X 30"	N/A	4"X 4", WOOD	NEW SIGN AND POST
010	B-LINE	203+04	15.0' LT	SPEED HUMP	W17-1	30" X 30"	N/A	4"X 4", WOOD	NEW SIGN AND POST
011	B-LINE	207+89	15.0' RT	SPEED HUMP	W17-1	30" X 30"	N/A	4"X 4", WOOD	NEW SIGN AND POST
012	B-LINE	208+12	15.0' LT	SPEED HUMP	W17-1	30" X 30"	N/A	4"X 4", WOOD	NEW SIGN AND POST
013	C-LINE	303+90	16.5' LT	STREET SIGN	CUSTOM	N/A	N/A	N/A	RELOCATE EXISTING SIGN AND POST
014	D-LINE	13+75	17.1' RT	STOP	R1-1	N/A	N/A	N/A	RELOCATE EXISTING SIGN AND POST
015	C-LINE	305+84	15.0' RT	SPEED HUMP	W17-1	30" X 30"	N/A	4"X 4", WOOD	NEW SIGN AND POST
016	C-LINE	306+07	15.0' LT	SPEED HUMP	W17-1	30" X 30"	N/A	4"X 4", WOOD	NEW SIGN AND POST
017	C-LINE	309+48	15' LT	SPEED LIMIT 15 MPH SLOW CHILDREN AT PLAY	R2-1 CUSTOM	N/A	N/A	N/A	RELOCATE EXISTING SIGN AND POST
018	E-LINE	21+93	25' RT	BUS STOP	CUSTOM	N/A	N/A	N/A	BUS STOP POST AND FLAG WILL BE PROVIDED AND INSTALLED BY COMMUNITY TRANSIT

LINE AND CURVE TABLE

	LINE TABLE: A-LINE				
LINE	LENGTH	BEARING			
L1	686.38	S0" 39" 11.07"W			
L2	196.08	S69° 25' 56.87"E			
L3	130.03	S61' 15' 30.42"E			
L4	190.98	S89° 28' 38.14"E			
L5	132.84	N79° 01' 26.09"E			

CURVE TABLE: A-LINE				
CURVE	LENGTH	RADIUS	CHORD DIRECTION	
C1	140.67	115.00	S34° 23' 22.90"E	
C2	303.16	2125.00	S65° 20' 43.64"E	
С3	263.49	535.00	S75* 22' 04.28"E	
C4	195.68	975.00	N84° 46' 23.98"E	

	LINE TABLE: B-LINE				
LINE LENGTH		BEARING			
L6	169.22	S87° 50' 27.84"E			
L7	119.75	S65° 03' 19.68"E			
L8	339.83	S64° 36' 33.78"E			
L9	137.21	S78° 18' 31.51"E			
L9	137.21	S78' 18' 31.5			

	CURVE TABLE: B-LINE				
CURVE	LENGTH	RADIUS	CHORD DIRECTION		
C5	99.42	250.00	S76* 26' 53.76"E		
C6	77.86	10000.00	S64° 49' 56.73"E		
C7	236.71	990.00	S71° 27' 32.64"E		

LINE TABLE: C-LINE			
LINE LENGTH		BEARING	
L10	227.71	S10° 44' 39.64"E	
L11	26.30	S36* 59' 31.12"E	
L12	167.69	N86° 17' 14.56"E	

CURVE TABLE: C-LINE				
CURVE	LENGTH	RADIUS	CHORD DIRECTION	
C8	251.96	550.00	S23* 52' 05.38"E	
C9	307.00	530.00	S53* 35' 10.43"E	
C10	112.95	275.00	S81° 56' 47.59"E	

LINE TABLE: D-LINE			
LINE LENGTH		BEARING	
L13	66.80	N25° 23' 26.22"E	
L14	39.91	N62* 51' 17.39"E	

		CURVE TABLE: D-LINE		
	CURVE	LENGTH	RADIUS	CHORD DIRECTION
N	C11	343.28	525.00	N44° 07' 21.80"E

LINE TABLE: E-LINE				
LINE LENGTH		BEARING		
L15	165.42	NO' 27' 58.38"E		
L16	229.96	N11' 41' 28.43"E		

		CURV	E TABLE:	E-LINE
+	CURVE	LENGTH	RADIUS	CHORD DIRECTION
-	C12	104.62	534.00	N6" 04" 43.41"E

	LINE TABLE: F-LINE			
LINE LENGTH		BEARING		
L17	195.75	S0° 29' 23.51"W		
L18	368.16	S58* 56' 07.11"E		

CURVE TABLE: F-LINE				
CURVE	LENGTH	RADIUS	CHORD DIRECTION	
C13	86.08	83.00	S29° 13' 21.80"E	

DESIGNED
R. CUSHMAN
DRAWN
B. PURGANAN REVISIONS CHECKED T. SMITH APPROVED H. LONGFELLOW

ONE INCH AT FULL SCALE, IF NOT, SCALE ACCORDINGLY FILE NAME PS.1598089701P02CH-01 WE No. 1598-089 T01 P02 DITE TO THE NO. 1598-089 T01 P02 DITE 2016





SILVER VILLAGE PAVEMENT PRESERVATION AND PEDESTRIAN IMPORVEMENTS THE TULALIP TRIBES


TULALIP, WA

Know what's below. Call before you dig.

LINE AND CURVE TABLES, SIGN SCHEDULES

SHEET NO. 26 OF 32

CH10

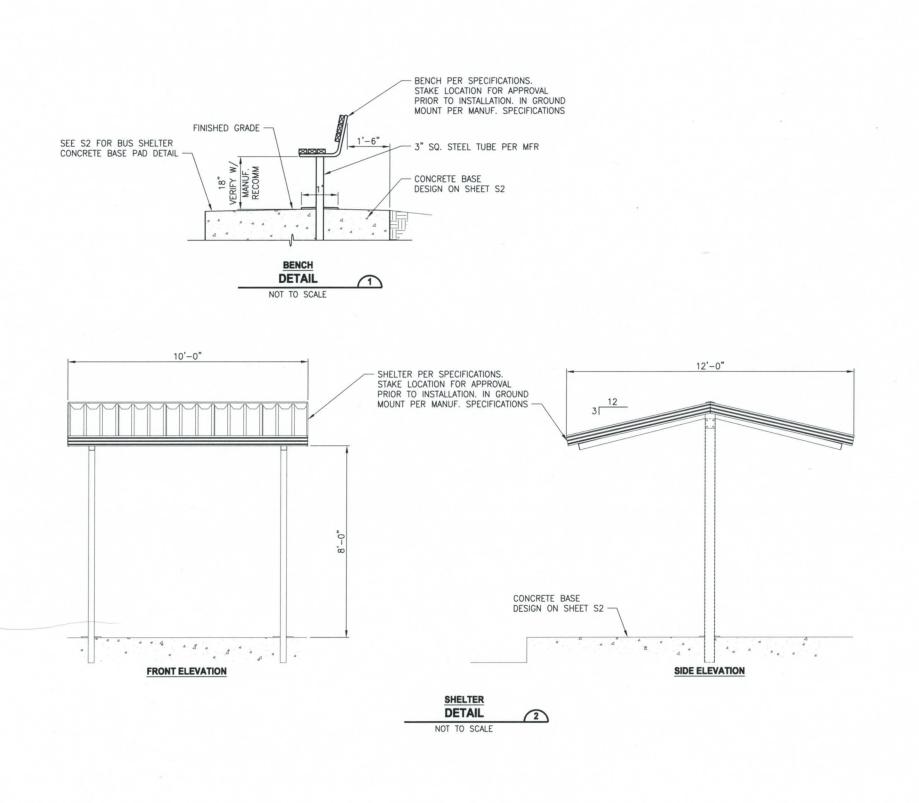

Know what's below. Call before you dig.

PROJECT NAME

SILVER VILLAGE PAVEMENT PRESERVATION AND PEDESTRIAN IMPORVEMENTS THE TULALIP TRIBES

TULALIP, WA

DETAILS

SHELTER DESIGN
 A. THIS SHELTER HAS BEEN DESIGNED AS AN OPEN STRUCTURE.
 THE ADDITION OF ANY ENCLOSURE SUCH AS WALLS, INSECT
 MESH, OR SHADE SCREENS SHALL BE PROHIBITED AS INCREASED
 WIND FORCES MAY RESULT.

2. FOUNDATION, SEE SHEET S2.

SHEET NO. 27 OF 32

DT1


REVISIONS DESIGNED R. CUSHMAN J. JUN CHECKED T. SMITH APPROVED H. LONGFELLOW

ONE INCH AT FULL SCALE IF NOT, SCALE ACCORDINGLY FILE NAME PS1598089T01P02DT-01 JOB No. 554-1598-089 T01 P02 DATE JUNE 2016



Parametrix ENGINEERING . PLANNING . ENVIRON

719 2ND AVENUE, SUITE 200 | SEATTLE, WA 98104 P 206.394.3700 WWW.PARAMETRIX.COM

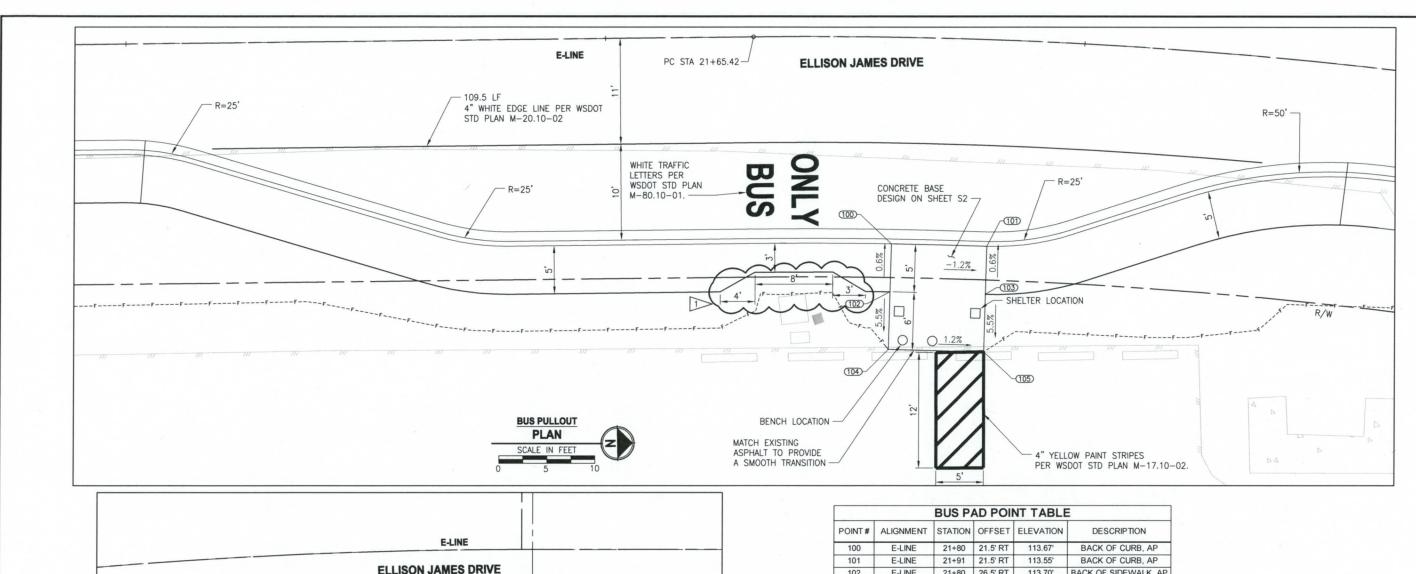

			E-LINE			
		ELLIS	SON JAMES D			
	(200) 1.2%	201)	1.2%	B-LINE	///	Ш
	203) 1.2% 8° 4'	(204) 60 100	1.2%	205)	 	The same of the sa
R/W	206)	200)	%	208		

DRIVEWAY TO WORSHIP CENTER PLAN

	BUS PAD POINT TABLE						
POINT#	ALIGNMENT	STATION	OFFSET	ELEVATION	DESCRIPTION		
100	E-LINE	21+80	21.5' RT	113.67'	BACK OF CURB, AP		
101	E-LINE	21+91	21.5' RT	113.55'	BACK OF CURB, AP		
102	E-LINE	21+80	26.5' RT	113.70'	BACK OF SIDEWALK, AF		
103	E-LINE	21+91	26.5' RT	113.58'	BACK OF SIDEWALK, AF		
104	E-LINE	21+80	32.5'	113.37'	BACK OF BUS PAD, AP		
105	E-LINE	21+91	32.5'	113.25'	BACK OF BUS PAD, AP		

DRIVEWAY TO WORSHIP CENTER POINT TABLE								
POINT#	ALIGNMENT	STATION	OFFSET	ELEVATION	DESCRIPTION			
200	E-LINE	22+39	11.5' RT	112.79'	BACK OF CURB, AP			
201	E-LINE	22+52	11.5' RT	112.64'	BACK OF CURB, MIDPOINT			
202	E-LINE	22+65	11.5' RT	112.49'	BACK OF CURB, AP			
203	E-LINE	22+39	16.5' RT	112.84'	BACK OF SIDEWALK, AP			
204	E-LINE	22+52	16.5' RT	112.69'	BACK OF SIDEWALK, MIDPOINT			
205	E-LINE	22+65	16.5' RT	112.54'	BACK OF SIDEWALK, AP			
206	E-LINE	22+39	25.0' RT	112.38'	DRIVEWAY LIMIT, AP			
207	E-LINE	22+52	25.0' RT	112.26'	DRIVEWAY LIMIT, MIDPOINT			
208	E-LINE	22+66	25.0' RT	112.12'	DRIVEWAY LIMIT, AP			



	REVISIONS	DATE	BY	DESIGNED J. JUN
1	PER REVIEW COMMENTS	7/25/16	RSC	DRAWN
				J. JUN CHECKED T. SMITH
_				APPROVED H. LONGFELLOW

ONE INCH AT FULL SCALE S1598089T01P02DT-02 JOB No. 554-1598-089 T01 P02 DATE JUNE 2016



Parametrix ENGINEERING . PLANNING . ENVIRON	NMENTAL SCIENCES
719 2ND AVENUE, SUITE 200 9 P 206.394.3700 WWW.PARAMETRIX.COM	SEATTLE, WA 98104

SILVER VILLAGE PAVEMENT PRESERVATION AND PEDESTRIAN IMPORVEMENTS THE TULALIP TRIBES

TULALIP, WA

BUS PULLOUT AND DRIVEWAY DETAIL

SHEET NO. 28 OF 32

DT2

GENERAL NOTES:


REFER TO CIVIL, DRAWINGS FOR LOCATION OF GATE BASE.


SUBMIT ALL REQUIRED SHOP DRAWINGS AND RECEIVE THEIR SATISFACTORY REVIEW FROM THE ENGINEER, PRIOR TO FABRICATION.


THE FENCE POST LOCATIONS ARE BASED ON FIELD MEASUREMENTS. THE CONTRACTOR SHALL VERIFY ALL DIMENSIONS AND CONDITIONS AT THE PROJECT SITE PRIOR TO STARTING WORK AND NOTIFY THE ENGINEER IMMEDIATELY OF ANY DISCREPANCIES.


STRUCTURAL NOTES:


- ALL MATERIALS AND WORKMANSHIP SHALL BE IN ACCORDANCE WITH THE REQUIREMENTS OF THE WSDOT STANDARD SPECIFICATIONS FOR ROAD, BRIDGE, AND MUNICIPAL CONSTRUCTION DATED 2016, AND AMENDMENTS.
- 2. THE CAST-IN-PLACE CONCRETE SHALL BE CLASS 4000.
- 3. REINFORCING STEEL SHALL BE IN ACCORDANCE WITH ASTM A615, GRADE 60.
- 4. PROVIDE 3/4" CHAMFER AT ALL EXPOSED EDGES AND OUTSIDE CORNERS ABOVE GRADE.

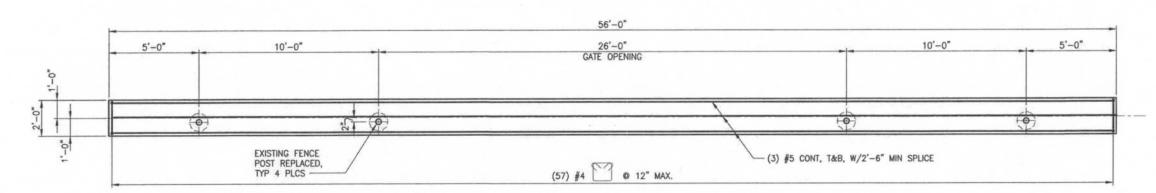

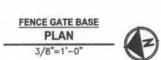

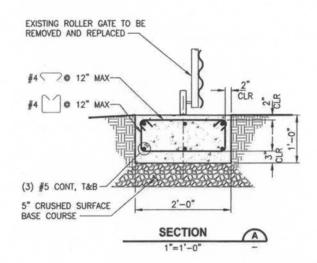

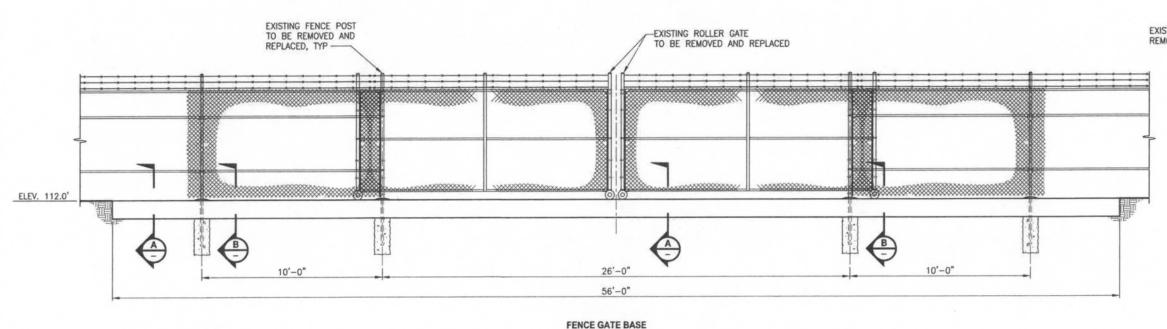

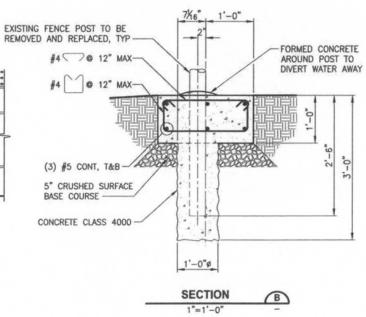

DATE BY

DESIGNED
B. SCHLACHTER

DRAWN
A. VALENCIA

CHECKED
T. SMITH

APPROVED
H. LONGFELLOW

ONE INCH AT FULL SCALE
IF NOT, SCALE ACCORDINGLY
FILE NAME
PS1598089T01P02S-01
JOB No.
554-1598-089 T01 P02
DATE
JUNE 2016



3/8"=1'-0"

Parametrix ENGINEERING PLANNING ENVIRONMENTAL SCIENCES		
719 2ND AVENUE, SUITE 200 SEATTLE, WA 98104 P 206.394.3700 WWW.PARAMETRIX.COM		


SILVER VILLAGE PAVEMENT PRESERVATION AND PEDESTRIAN IMPORVEMENTS THE TULALIP TRIBES TULALIP, WA


MAINTENANCE BUILDING ROLLER GATE PAD


Know what's below. Call before you dig.


> SHEET NO. 29 OF 32

> > **S1**

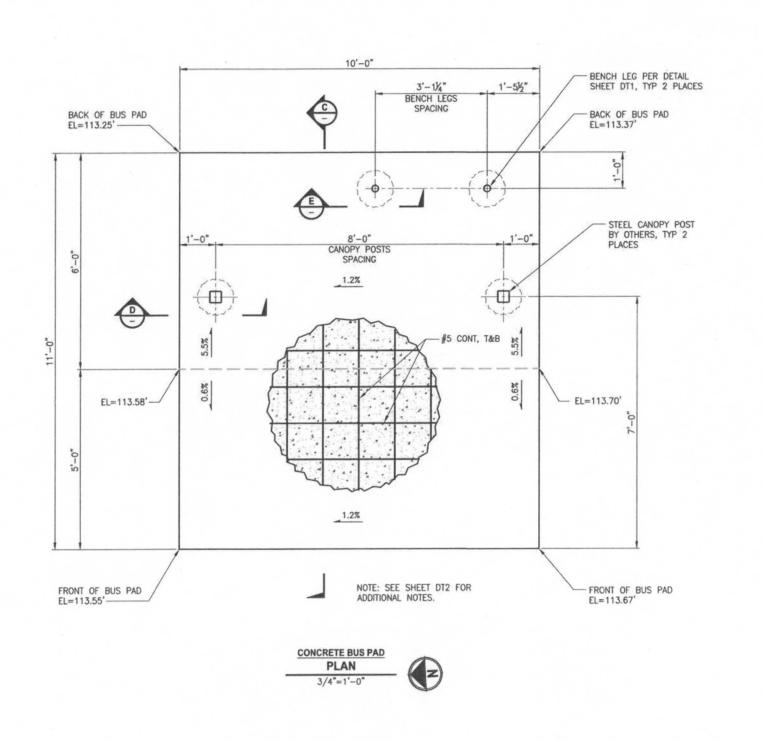

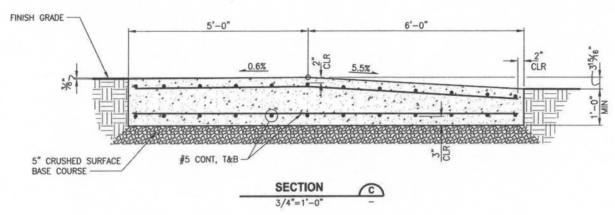

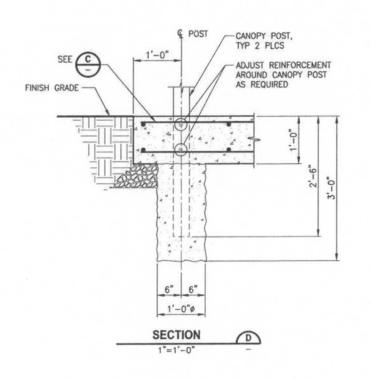

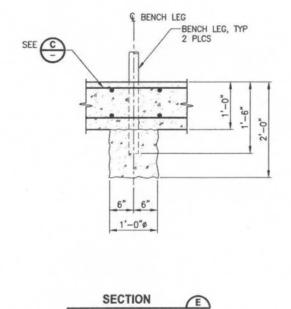



REVISIONS	DATE	BY	DESIGNED B. SCHLACHTER
			DRAWN A. VALENCIA
		+	CHECKED T. SMITH
			APPROVED H. LONGFELLOW

ONE INCH AT FULL SCALE, IF NOT, SCALE ACCORDINGLY FILE NAME PS1598089T01P02S-01 JOB No. 554-1598-089 T01 P02 DATE JUNE 2016





Parametrix ENGINEERING, PLANNING, ENVIRONMENTAL SCIENCES					
719 2ND AVENUE, SUITE 200 SEATTLE, WA 98104 P 206, 394, 3700					

SILVER VILLAGE PAVEMENT PRESERVATION
AND PEDESTRIAN IMPORVEMENTS
THE TULALIP TRIBES
TULALIP, WA


BUS SHELTER CONCRETE BASE PAD SHEET NO. 30 OF 32

S2

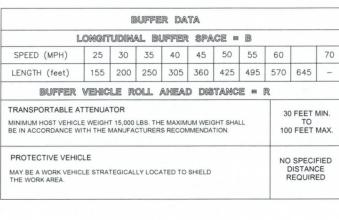

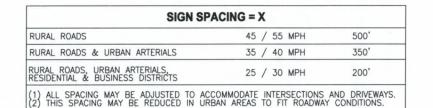

CHANNELIZATION DEVICE SPACING (feet) TAPER TANGENT 50/65 10 to 20 80 35/45 10 to 20 60 25/30 10 to 20 40

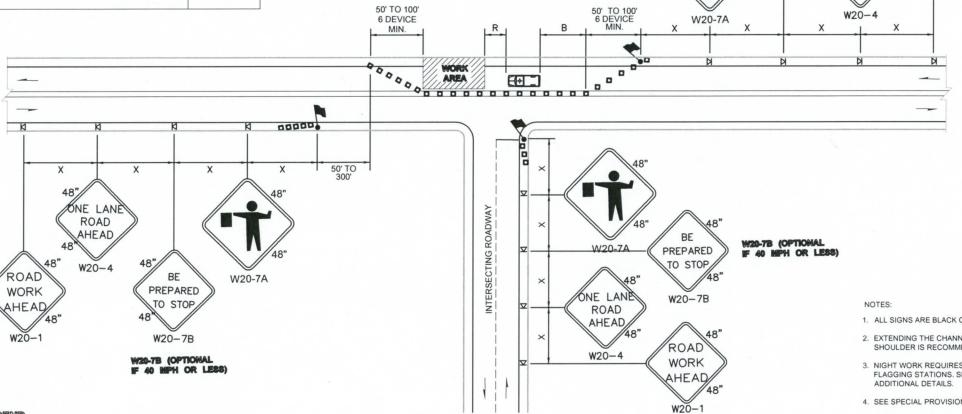

1. ALL SIGNS ARE BLACK ON ORANGE

ROAD

WORK

AHEAD

W20 - 1

ONE LANE

ROAD

AHEAD

- EXTENDING THE CHANNELIZING DEVICE TAPER ACROSS SHOULDER IS RECOMMENDED.
- 3. NIGHT WORK REQUIRES ADDITIONAL ROADWAY LIGHTING AT FLAGGING STATIONS. SEE THE STANDARD SPECIFICATIONS FOR ADDITIONAL DETAILS.
- 4. SEE SPECIAL PROVISIONS FOR WORK HOUR RESTRICTIONS.
- SIGNS SHALL BE 48" X 48" BLACK ON RETRO-REFLECTIVE ORANGE BACKING AND MEET THE NCHRP 350 CRASH WORTHY REQUIREMENTS.
- 6. ALL TRAFFIC CONTROL DEVICES SHALL BE REMOVED DURING NON-WORK HOURS.
- 7. ALL SIGNS TO BE IN PLACE 3 DAYS OR LONGER SHALL BE POST MOUNTED.
- 8. ACCESS TO EXISTING DRIVEWAYS SHALL BE MAINTAINED AT ALL TIMES EXCEPT FOR A MAXIMUM 4-HOUR PAVING WINDOW
- ADDITIONAL TRAFFIC CONTROL REQUIREMENTS SHALL ADHERE TO SPECIAL PROVISIONS SECTION 1-07.23(1).

Know what's below. Call before you dig.

ONE-LANE. TWO-WAY TRAFFIC CONTROL WITH FLAGGERS

NOT TO SCALE

REVISIONS ESIGNED B. MAY T. SMITH PPROVED
H. LONGFELLOW

LEGEND

FLAGGING STATION

PROTECTIVE VEHICLE

TEMPORARY SIGN LOCATION

CHANNELIZING DEVICES

ONE INCH AT FULL SCALE 1598089T01P02TC-01 554-1598-089 T01 P02



Parametrix 719 2ND AVENUE, SUITE 200 | SEATTLE, WA 98104 P 206.394.3700 WWW.PARAMETRIX.COM

SILVER VILLAGE PAVEMENT PRESERVATION AND PEDESTRIAN IMPORVEMENTS THE TULALIP TRIBES

TULALIP, WA

W20-7B (OPTIONAL IF 40 MPH OR LESS)


PREPARED


TO STOP

W20-7B

TEMPORARY TRAFFIC CONTROL PLAN 31 OF 32

TC1

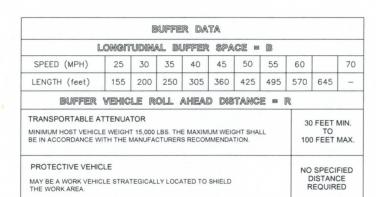

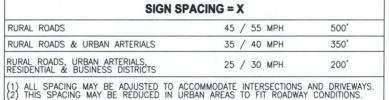

CHANNELIZATION DEVICE SPACING (feet)

MPH TAPER TANGENT

50/65 10 to 20 80

35/45 10 to 20 60

25/30 10 to 20 40

50' TO 100' 6 DEVICE MIN.

R

B

W20-7B

ONE LANE
ROAD
AHE AD
48"

W20-4

X

X

X

X

AREA

AREA

AREA

AREA

ONE LANE
ROAD
AHE AD
AHE AD
AHE
AD
AHE
AD
AHE
AND
AHE

- LEGEND
 FLAGGING STATION
- H TEMPORARY SIGN LOCATION
- D CHANNELIZING DEVICES

PROTECTIVE VEHICLE

MIDBLOCK
ONE-LANE, TWO-WAY TRAFFIC CONTROL
WITH FLAGGERS
NOT TO SCALE

NOTES

W20-7B (OPTIONAL IF 40 MPH OR LESS)

BE

PREPARED

TO STOP

- 1. ALL SIGNS ARE BLACK ON ORANGE
- 2. EXTENDING THE CHANNELIZING DEVICE TAPER ACROSS SHOULDER IS RECOMMENDED.

ROAD

WORK

AHEAD

- NIGHT WORK REQUIRES ADDITIONAL ROADWAY LIGHTING AT FLAGGING STATIONS. SEE THE STANDARD SPECIFICATIONS FOR ADDITIONAL DETAILS.
- 4. SEE SPECIAL PROVISIONS FOR WORK HOUR RESTRICTIONS.
- SIGNS SHALL BE 48" X 48" BLACK ON RETRO-REFLECTIVE ORANGE BACKING AND MEET THE NCHRP 350 CRASH WORTHY REQUIREMENTS.
- ALL TRAFFIC CONTROL DEVICES SHALL BE REMOVED DURING NON-WORK HOURS.
- ALL SIGNS TO BE IN PLACE 3 DAYS OR LONGER SHALL BE POST MOUNTED.
- ACCESS TO EXISTING DRIVEWAYS SHALL BE MAINTAINED AT ALL TIMES EXCEPT FOR A MAXIMUM 4-HOUR PAVING WINDOW.
- ADDITIONAL TRAFFIC CONTROL REQUIREMENTS SHALL ADHERE TO SPECIAL PROVISIONS SECTION 1-07.23(1).

Know what's below. Call before you dig.

REVISIONS	DATE	BY	DESIGNED B. MAY
			DRAWN B. MAY
		-	CHECKED T. SMITH
		+	APPROVED H. LONGFELLOW

ONE INCH AT FULL SCALE. IF NOT, SCALE ACCORDINGLY
FILE NAME
PS1598089T01P02TC-01
J08 No.
554-1598-089 T01 P02
DATE
JUNE 2016



50' TO 300'

Parametrix ENGINEERING . PLANNING . ENVIRONMENTAL SCIENCES	S PR
719 2ND AVENUE, SUITE 200 SEATTLE, WA 98104 P 206.394.3700 WWW.PARAMETRIX.COM	

PROJECT NAME

ILVER VILLAGE PAVEMENT PRESERVATION AND PEDESTRIAN IMPORVEMENTS THE TULALIP TRIBES

TULALIP, WA

TEMPORARY
TRAFFIC CONTROL PLAN

SHEET NO. 32 OF 32

TC2